

**FLOORING KEY**

- AREA TO BE DalRollo Satin - Heron
- CARPET Prairie 24 - Railhead Grey - Quarter turn
- CARPET Prairie 24 - Curlew Grey - Monolithic


**PARTITION LEGEND**

- Plasterboard wall
- Plasterboard wall with ply board
- Formlite Partitioning
- Feature wall structure
- Plasterboard wall slab to slab

**OCCUPANCY**

- Workstations - 55 + Sublet
- Meeting Rooms - 5
- Offices - 2

**WORKSTATIONS**

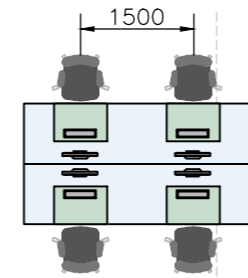

**AREA**

- 521.2 sqm
- 5 610 sqf

**OTHER FURNITURE**

- BESPOKE JOINERY SUPPLIER 1
- FURNITURE ITEM BY OTHER
- EXISTING CLIENT FURNITURE

**PAINTED WALL FINISH**

- EGG SHELL PAINT



**AS BUILT THIRD FLOOR GENERAL LAYOUT**

THIS DRAWING REMAINS THE PROPERTY OF BASE INTERIORS LTD. IT MAY NOT BE COPIED OR REPRODUCED WITHOUT EXPRESS WRITTEN CONSENT. FIGURED DIMENSIONS SHOULD BE USED WHERE GIVEN. DO NOT SCALE.

**Cheil**  
 CLIENT  
 The Crane building  
 22 Lavington Street  
 London SE1 0NZ  
 SITE ADDRESS

As built Third Floor  
 DRAWING TITLE

|   |             |
|---|-------------|
| CHE 308   | 3 001       |
| PROJECT NO.   | DRAWING NO. |
| 1: 100 on A2  | General     |
| SCALE   | DESCRIPTION |
| A.V   | 05-06-14    |
| DRAWN   | DATE        |
| T. 020 7487 3222<br>F. 020 7487 3555<br>BASEINTERIORS |             |
| <b>BASE</b><br>15 BERKELEY MEWS LONDON W1H 7AX        |             |

