


SCALE BAR IN mm
 0 1000 2000 3000 4000 5000 6000 7000 8000 9000 10000

DO NOT SCALE ANY DIMENSIONS OFF THIS DRAWING. ANY DISCREPANCIES BETWEEN THIS DRAWING AND OTHER INFORMATION ARE TO BE REFERRED TO NEW ARCHITECTURE LIMITED. WHERE THE DRAWING RELATES TO AN EXISTING BUILDING OR COMPLETED CONSTRUCTION THE CONTRACTOR IS RESPONSIBLE FOR CHECKING THAT THERE IS NO CONFLICT BETWEEN ACTUAL BUILDING DIMENSIONS AND DRAWING DIMENSIONS. IN THE EVENT OF DISCREPANCIES BETWEEN THE DRAWING AND SUBCONTRACTOR'S APPROVED WORKING DRAWINGS FOR RELEVANT BUILDING COMPONENTS, THE SUBCONTRACTOR'S DRAWING SHALL TAKE PRECEDENCE. ANY COMPLETELY MISSING OR OUT OF INFORMATION AS NOTED ABOVE MUST BE REPORTED IMMEDIATELY TO NEW ARCHITECTURE LIMITED. THIS DRAWING IS THE COPYRIGHT OF NEW ARCHITECTURE LIMITED. ALL DIMENSIONS ARE IN MILLIMETRES UNLESS OTHERWISE STATED.

INDICATES AREA OF ADDITIONAL WORKS

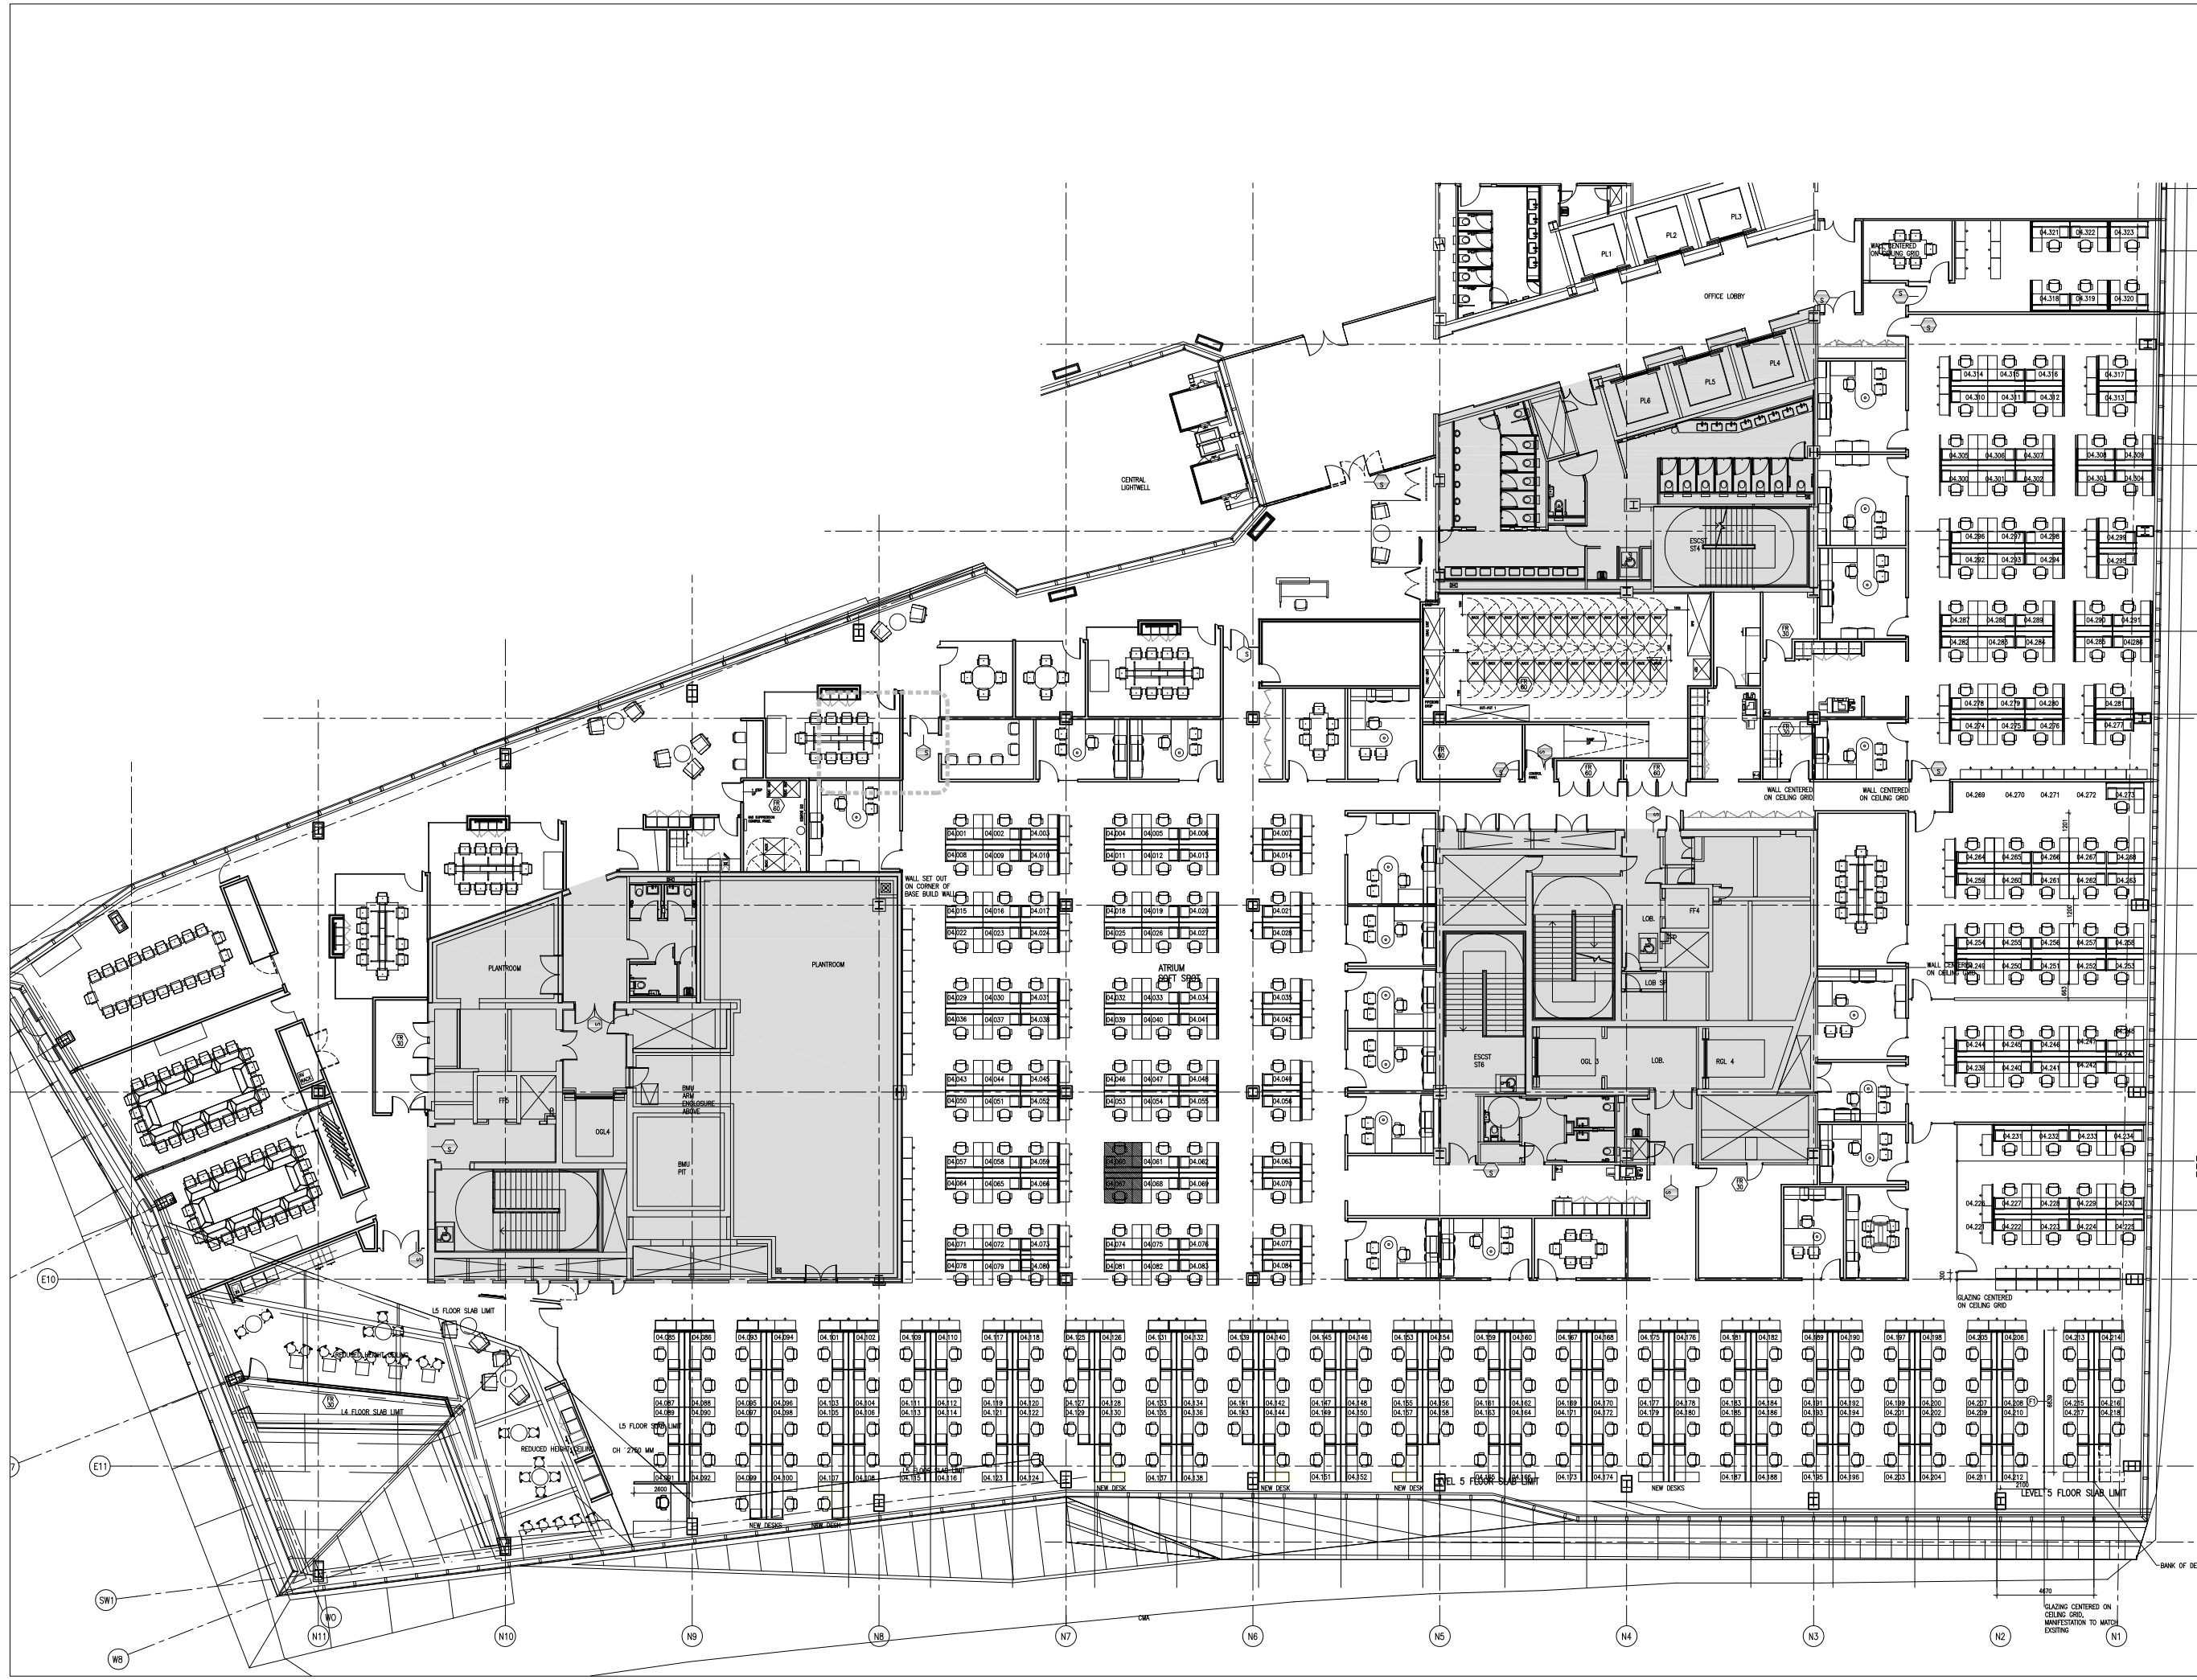

F1 27.08.13 NEW WORKS - AMENDMENTS TO LAYOUT
 REV DATE PURPOSE OF ISSUE

CLIENT CME GROUP
 PROJECT ONE NEW CHANGE LONDON EC4
 DRAWING FOURTH FLOOR SPACE PLAN SHOWING ADDITIONAL WORKS
 STATUS: PRELIMINARY
 TENDER
 CONSTRUCTION
 AS BUILT
 DRAWN BY: ERWIN/TB
 CHECKED BY: KB
 DRAWING NO. P13-099/A/OP/04/01/P3

MCM
 MCM Architecture Limited T 020 7902 0000 F 020 7922 1233
 11, Nelson Street London EC1N 7LJ, UK
 www.mcm-architects.com