

This drawing is protected under Copyright and at no time must any portion of this drawing be reproduced or copied in anyway without the permission of Morgan Lovell. All dimensions must be checked on site and NOT scaled from this drawing.

SUBJECT TO SITE SURVEY
CHECK SURVEY UNDERTAKEN ONLY
BUILDING PARAMETERS TAKEN FROM DRAWINGS PROVIDED
BUILDING PARAMETERS TAKEN FROM AS BUILT DRAWINGS PROVIDED

Rev	Revision	By	Date
J	BUILDING STOREWALL/RECEPTION ALL CHANGED POST MEET	NW	28/10/13
H	FURNITURE TO THE SHARED OFFICE ALTERED	NW	22/10/13
G	GLAZED DOORS INTRODUCED TO ALL OFFICES	NW	14/10/13
F	RECEPTION LAYOUT ALTERED	NW	12/09/13
E	TEAPOINT AND PARTITION LAYOUT ALTERED	NW	28/08/13
D	BOARDROOM AND MEETING ROOM ALTERED	NW	05/08/13
C	COMPLETE REVISION OF OFFICE LAYOUT	NW	22/07/13
B	BOARDROOM FURNITURE ALTERED	NW	19/07/13
A	ENTIRE LAYOUT REWISED TO CLIENT COMMENTS	NW	19/07/13

CONSTRUCTION

Morgan Lovell
 Inspiring office transformation

Ascot House, Finchampstead Road, Wokingham, Berks RG40 2NW
 T: 0118 899 5200 F: 0118 899 5201 E: contact@morganlovell.com
 W: <http://www.morganlovell.com>


C&N MAYFAIR LTD

Project
 15 SACKVILLE STREET
 MAYFAIR
 LONDON
 W1

Title
GROUND FLOOR
GENERAL LAYOUT

Scale	Date	Designed/Drawn By	Checked By / Date
1:500@A1	03/07/13	NW	-

Drawing Number	Project No.	Floor	Drawing No.	Rev
MA1115	0	100	J	

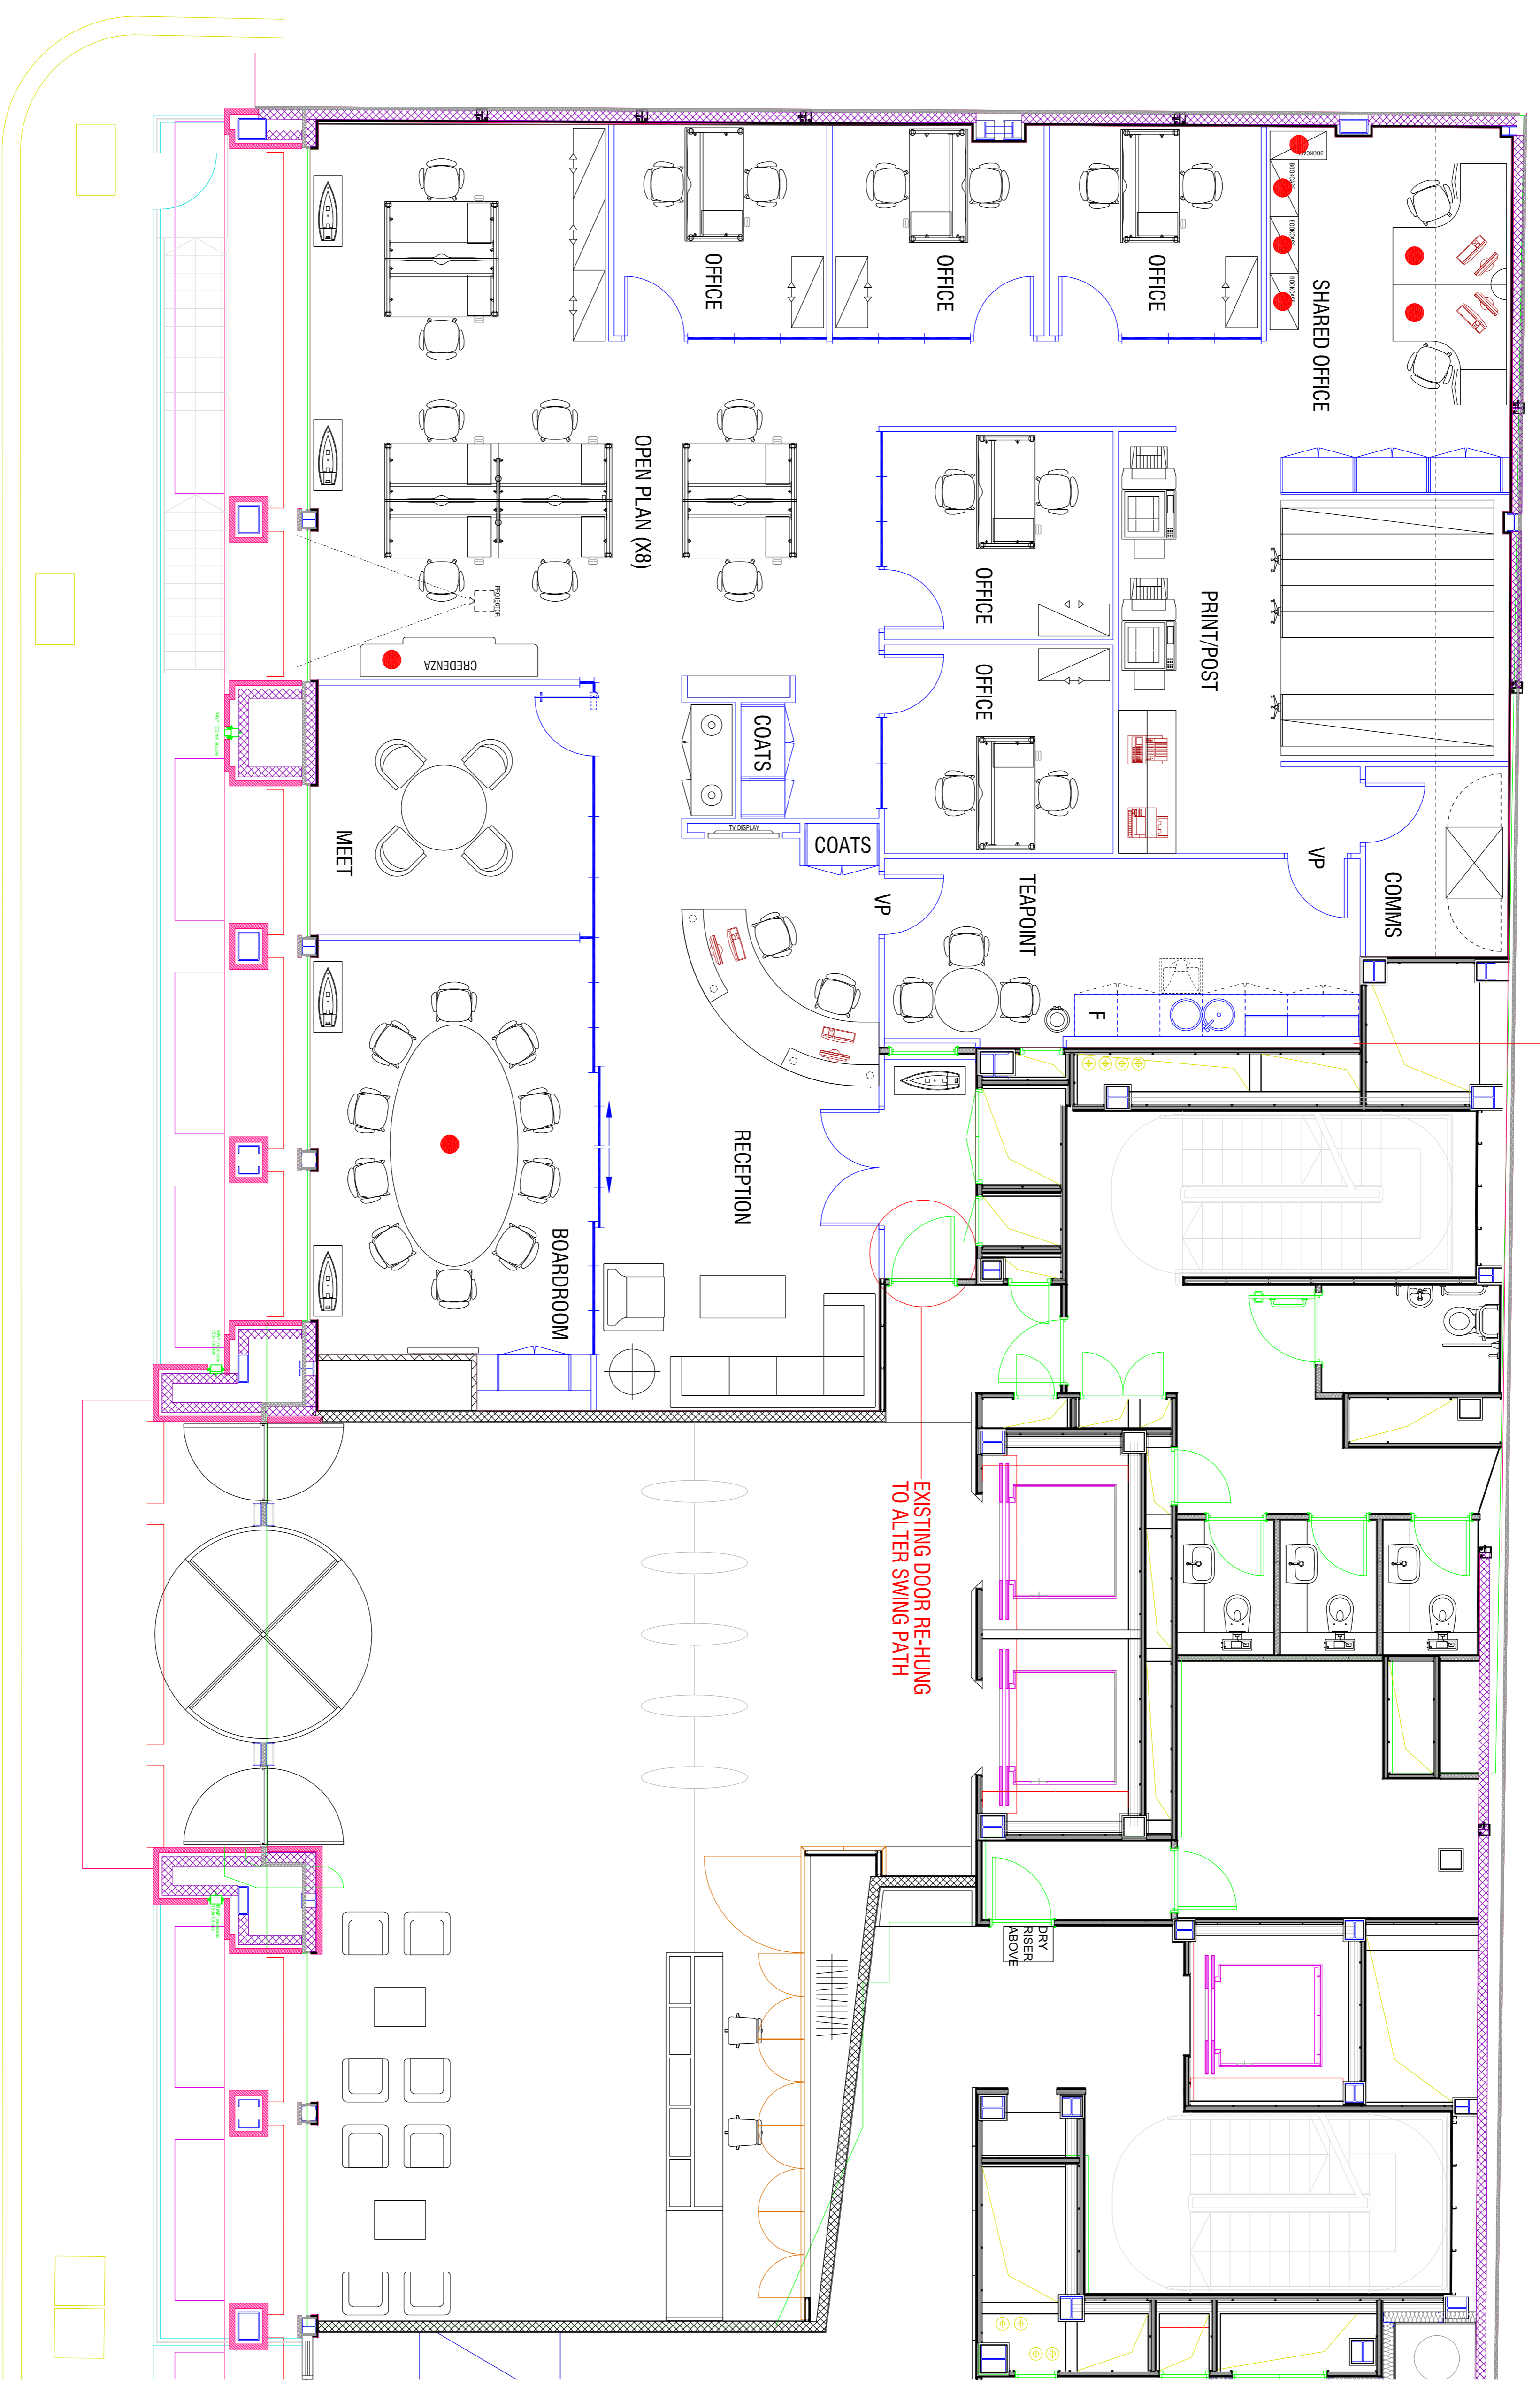

● : EXISTING CLIENT FURNITURE

SERVICES VOID

EXISTING DOOR RE-HUNG TO ALTER SWING PATH

DRY RISER ABOVE