


This drawing is the property of Woodalls Design LLP and may not be copied or reproduced without consent. All dimensions must be checked on site before commencing work. No dimensions to be scaled from drawing. Woodalls Design LLP asserts full Intellectual Property Rights in connection with designs, layouts and information contained within this drawing. Rights are transferred to the named client only upon receipt of full agreed payment in connection with services provided.

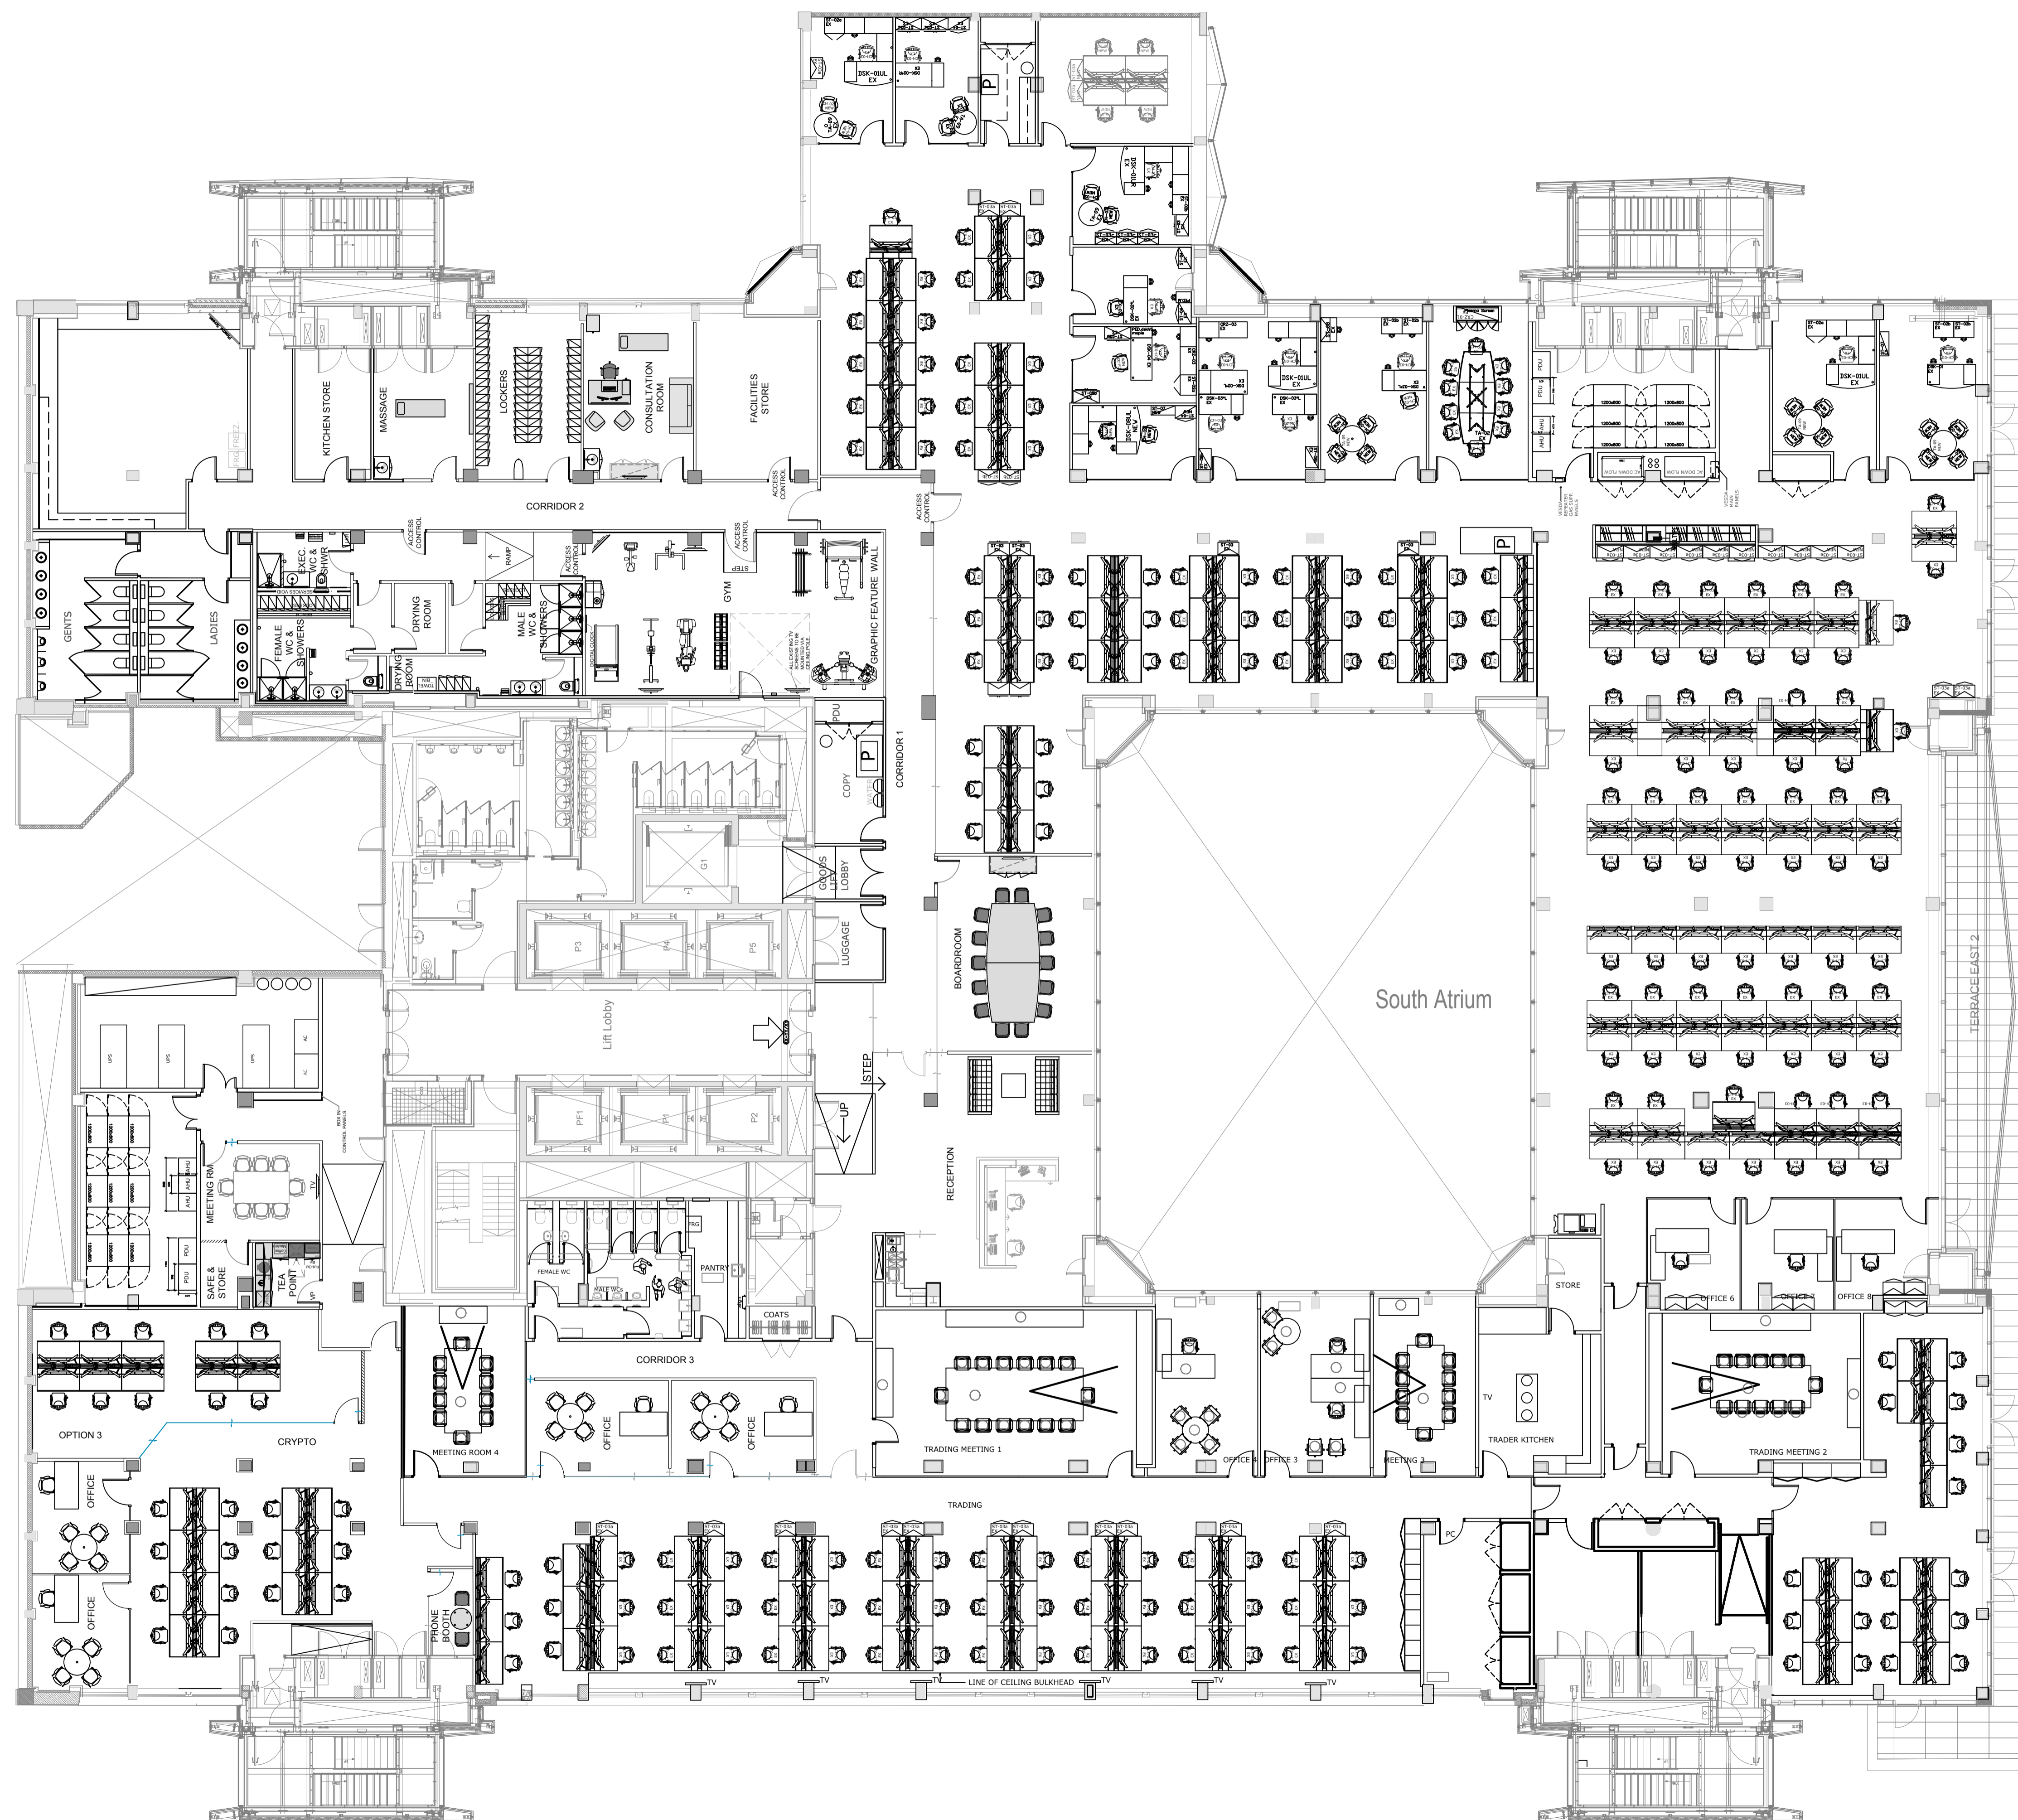

Revision	Description	Date	By	Ckd
----------	-------------	------	----	-----

### As Built

Project No: 00000 Date:

Client: Brevan Howard

Project Address:  
55 Baker Street  
London  
W1U 8EW

Drawing Title:  
General Arrangement

Drawn: AS Scale: NTS

Checked: AA Date Created: 12.04.2019

**Woodalls** Victoria House  
1-3 College Hill  
London EC4R 2RA  
+44 (0)20 7489 7669

Project Name	Floor	Series	Stage	Revision
BRVH	01	010	AB	