


All dimensions to be verified on site by Contractor before the start of any shop drawings or work whatsoever, either on their own behalf or that of sub-contractors.

Report any discrepancies to the Designer or Project Manager at once.

This drawing is to be read with all other Architect's and Engineer's drawings and other relevant information.

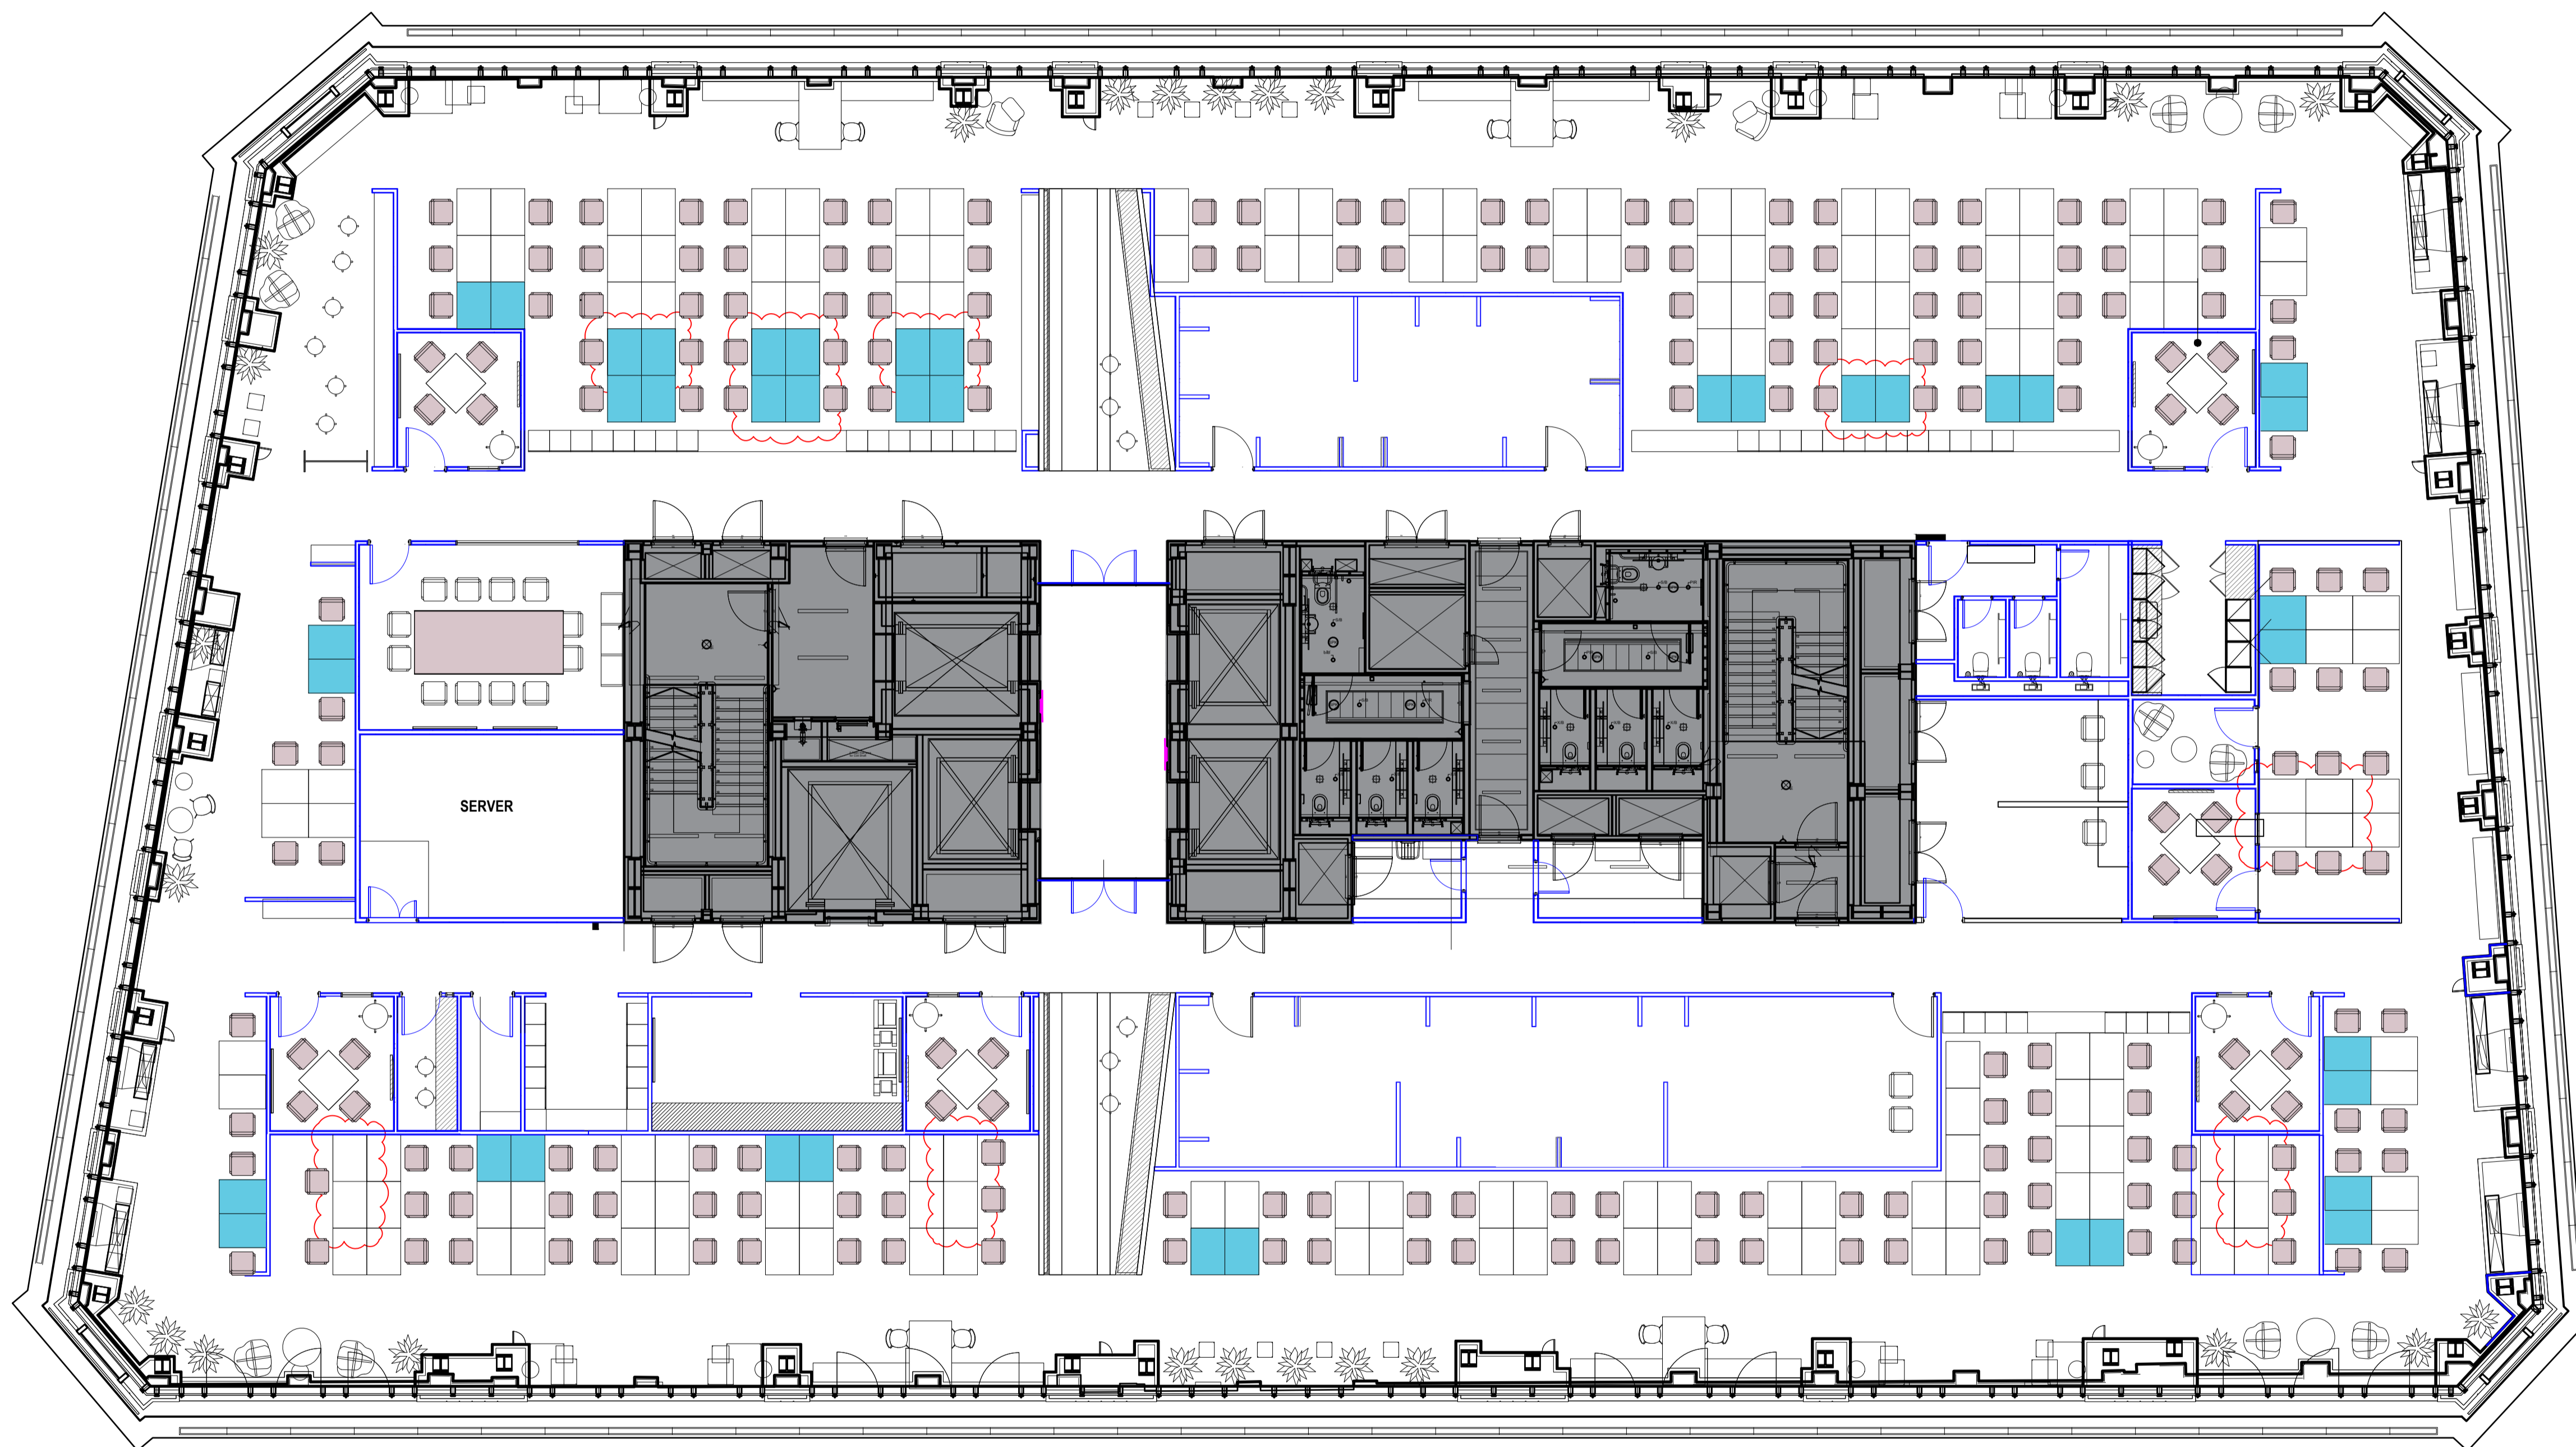

- HEIGHT ADJUSTABLE DESK
- LARGE SINGLE DESK LABELED AS 2 WORKSTATIONS

- Digital (Hbz, Esq, H&F)
- Cosmo
- People Team
- Health & Fitness
- Elle
- Esquire
- MDs
- Hearst Ventures
- Harper's Bazaar



silver birch design

architect interior design environment

Drawing Stage: **AS BUILT**

Planning	Design	Tender	Construction	As Built
B	14.03.18	As Built Issue		CB RF
A	14.02.18	Desks added		KK CB
Revision	Date	Description		Drwn Chk

Project: **Project Blackbird, LSQ 30 Pantan Street**

Title of Drawing: **Level 05 Desk Numbers**

Client: **Hearst UK**

Drawn: **CB** Checked: **RP** Original Date Generated: **15 01 18** Scale: **1:100** Paper Size: **A1**

Job No. **111001** Dwg No. **7005** Revision No. **B**