

This drawing may not be copied, reproduced or given to any third parties for any reason whatsoever without the written permission of Loop Interiors International Ltd. Please note this drawing and design is protected under Copyright and remains the property of Loop Interiors International Ltd at all times. Proposals are subject to approval by statutory authorities.
 © Copyright 2023 Loop Interiors International Ltd.


Standard Instructions

- A: All dimensions to be verified on site & any discrepancies on the drawings or divergence between drawings to be immediately reported to the Project Manager before putting the work concerned in hand, fabricating the work or preparing shop drawings.
- B: Work to figured dimensions only (except where full size details are provided).
- C: Do not vary any work shown on the drawings without obtaining prior approval from the Project Manager or Designer.
- D: Any additional information required should be requested from the Project Manager or Designer before commencement of work on site.

FOR COMMENT

- A: APPROVED
- B: APPROVED WITH COMMENT
- C: INFORMATION
- D: CONSTRUCTION
- E: AS BUILT

CLIENT SIGNATURE: _____

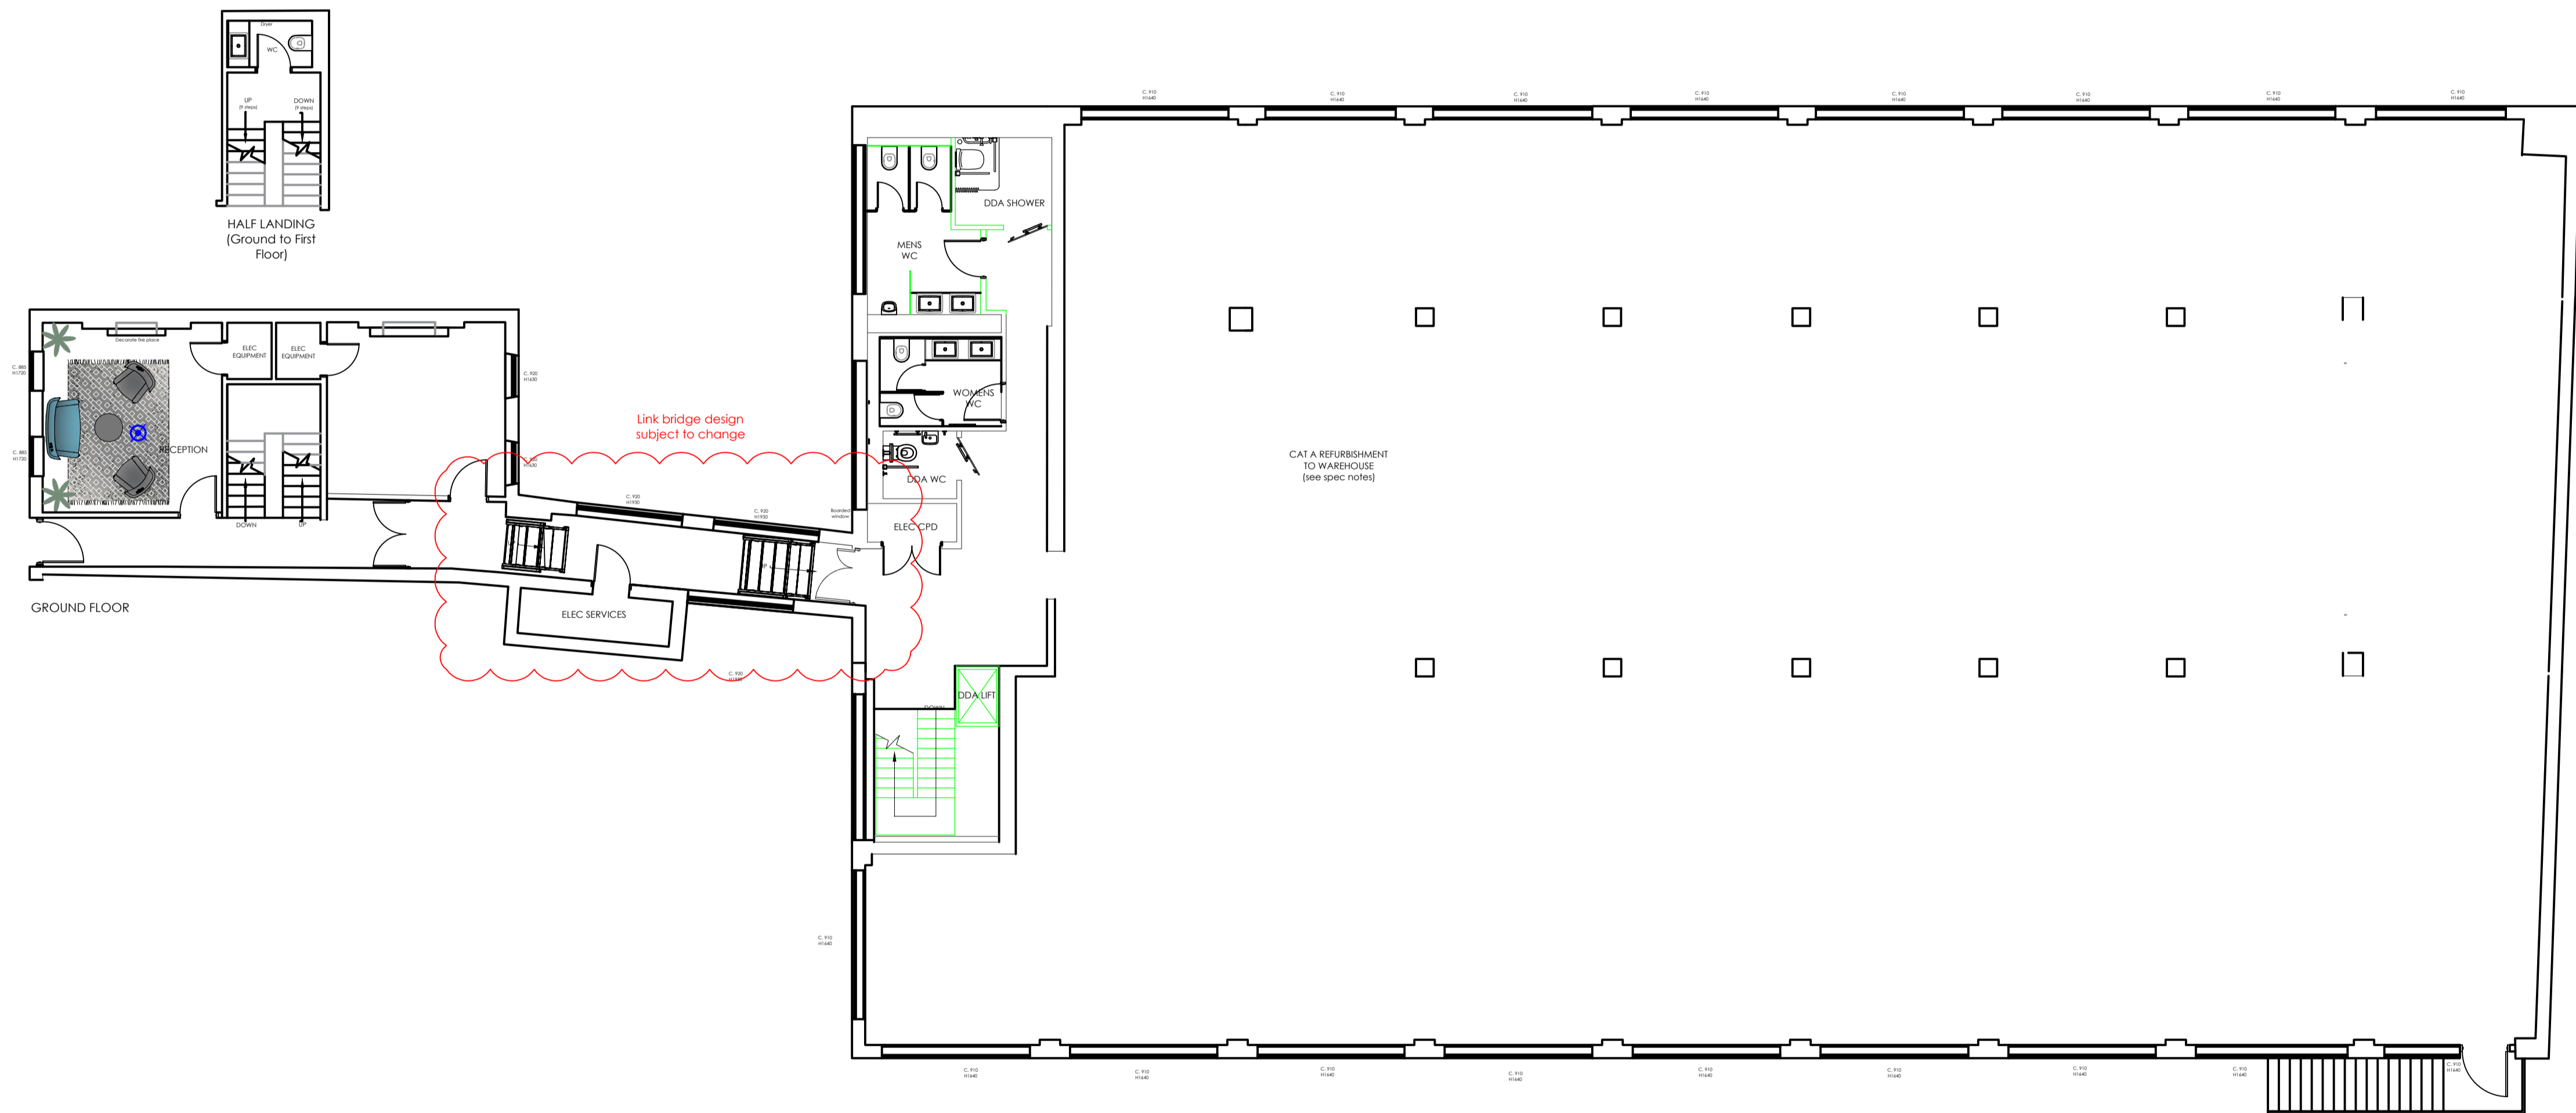

Ceiling Height	Sill Height	Floor Type
TBC	TBC	N/A

E	ISSUED_FOR_CONTRACT	30.05	CS
D	ISSUED_FOR_APPROVAL	17.05	CS
C	REVISED_LAYOUT	10.05	CS
B	REVISED_LAYOUT	09.05	CS
A	REVISED_LAYOUT	31.03	LN

Revision	Description	Date	By
----------	-------------	------	----



LOOP LOCAL
 7 Borell Yard, Farnham
 GU9 7NU
 Tel: +44 (0) 20 3772 6000
 www.loopinteriors.com

Client Name:
COLEBROOKE ROW

Project Address:
**46 COLEBROOKE ROW
 LONDON
 N1 8AF**

Drawing Title:
PROPOSED_GROUND_FLOOR

Drawing Scale:	Drawn By:	Date Created:
1:100@A1	JD	02.02.23

Project Number	Floor Number	Drawing Type	Revision
LL1577	00	GA	E