

**NOTE:**



RECORD DRAWINGS WILL ONLY REFLECT FORMAL CHANGES TO THE DESIGN DURING CONSTRUCTION, TO REPRESENT MAIN CONTRACTOR DESIGN, AND NOT NECESSARILY TO BE DEEMED AS BUILT INFORMATION. RECORD DRAWINGS REPRESENT ARCHITECTURAL INFORMATION ONLY AND FOR FURTHER INFORMATION, THE RELEVANT CONSULTANTS RECORD DRAWINGS SHOULD BE REFERRED TO.


1. ALL DIMENSIONS IN MM UNLESS OTHERWISE STATED. DO NOT SCALE OFF DRAWING

2. PRINT IN COLOUR

3. BACKGROUND INFORMATION BASED ON SURVEY INFORMATION BY TERRA MEASUREMENT - 1534\_GEORGE, OXFORD\_REV\_A, 1534\_GEORGE\_STREET\_FLOOR\_PLANS

4. PARTY WALLS SHOWN INDICATIVELY


 EXISTING WALL CONSTRUCTION  
 NEW WALL CONSTRUCTION

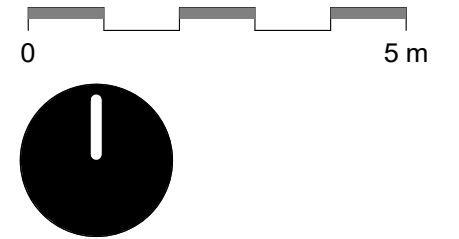

REVISION	DATE	DESCRIPTION	ARCHITECT	PARTNER
S2 P 1	10.06.20	Issued For Information	GM	ADP
S2 P 2	23.06.20	Stage 2	GM	ADP
S2 P 3	31.08.20	Stage 3 Update	GM	ADP
S2 P 4	22.09.20	Stage 3 Update	GM	ADP
S2 P 5	02.11.20	Tender Issue	GM	ADP
S2 P 6	04.12.20	Tender Issue	GM	ADP
S2 C 7	30.12.21	Revised to include site requests / CVIs	RG	ADP
CR C 8	31.03.23	CONSTRUCTION RECORD	RG	ADP

CHECK ALL DIMENSIONS AND VERIFY ON SITE. REPORT ANY ERRORS OR OMISSIONS

**CONSTRUCTION RECORD**




Cantay House  
 Park End Street, Oxford OX1 1JD  
 T +44 (0) 1865 248045  
 E oxford@adp-architecture.com  
 www.adp-architecture.com

**JOB TITLE:**  
 GEORGE STREET  
 REFURBISHMENT

**DRAWING TITLE:**  
 GENERAL ARRANGEMENT - BASEMENT

<b>SCALE:</b> 1 : 100	<b>DRAWING SHEET SIZE:</b> A3
<b>JOB CODE:</b> GSR	<b>DRAWING NUMBER:</b> ADP-00-B1-DR- A-1025
<b>REVISION:</b> CR C 8	

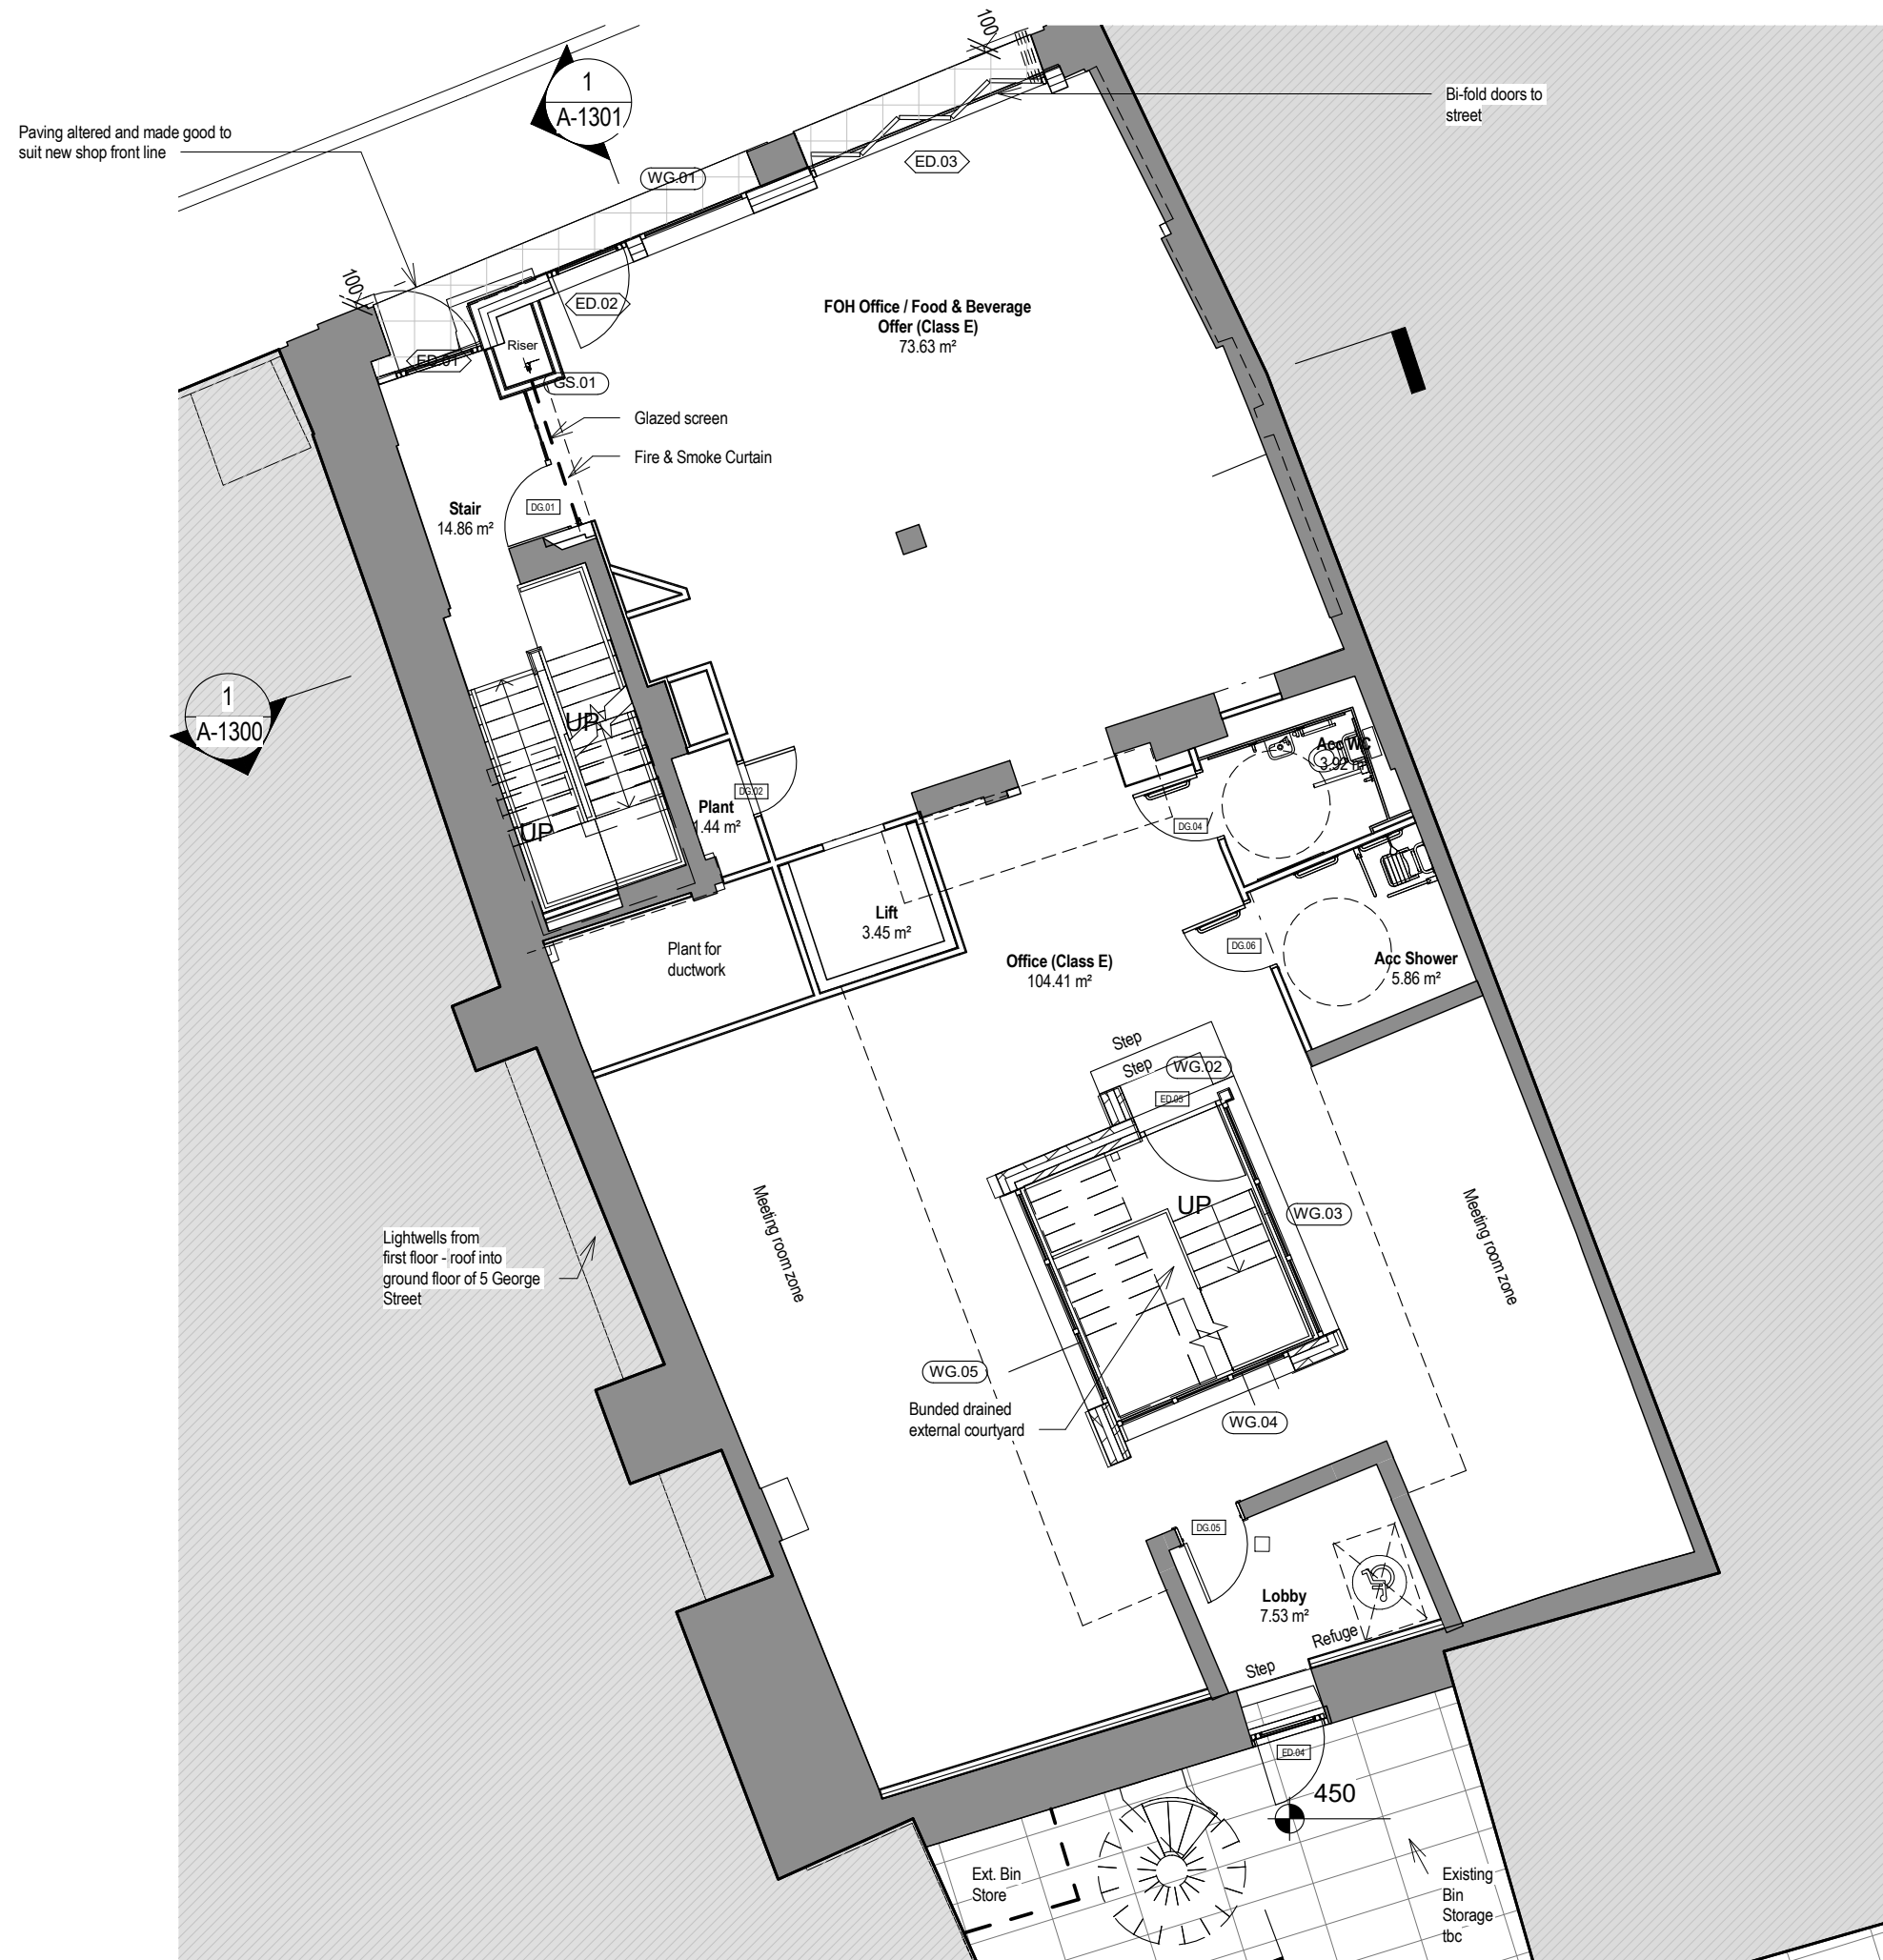

**NOTE:**

RECORD DRAWINGS WILL ONLY REFLECT FORMAL CHANGES TO THE DESIGN DURING CONSTRUCTION, TO REPRESENT MAIN CONTRACTOR DESIGN, AND NOT NECESSARILY TO BE DEEMED AS BUILT INFORMATION. RECORD DRAWINGS REPRESENT ARCHITECTURAL INFORMATION ONLY AND FOR FURTHER INFORMATION, THE RELEVANT CONSULTANTS RECORD DRAWINGS SHOULD BE REFERRED TO.

1. ALL DIMENSIONS IN MM UNLESS OTHERWISE STATED. DO NOT SCALE OFF DRAWING


2. PRINT IN COLOUR

3. BACKGROUND INFORMATION BASED ON SURVEY INFORMATION BY TERRA MEASUREMENT - 1534\_GEORGE, OXFORD\_REV\_A, 1534\_GEORGE\_STREET\_FLOOR\_PLANS

4. PARTY WALLS SHOWN INDICATIVELY

EXISTING WALL CONSTRUCTION

NEW WALL CONSTRUCTION

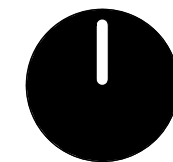

REVISION	DATE	DESCRIPTION	ARCHITECT	PARTNER
S2 P 1	10.06.20	Issued For Information	GM	ADP
S2 P 2	23.06.20	Stage 2	GM	ADP
S2 P 3	31.07.20	Issued For Information	GM	ADP
S2 P 4	31.08.20	Stage 3 Update	GM	ADP
S2 P 5	22.09.20	Stage 3 Update	GM	ADP
S2 P 6	02.11.20	Tender Issue	GM	ADP
S2 P 7	04.12.20	Tender Issue	GM	ADP
S2 C 8	30.12.21	Revised to include site requests / CVIs	RG	ADP
CR C 9	31.03.23	CONSTRUCTION RECORD	RG	ADP

CHECK ALL DIMENSIONS AND VERIFY ON SITE. REPORT ANY ERRORS OR OMISSIONS


**CONSTRUCTION RECORD**

Cantay House  
Park End Street, Oxford OX1 1JD  
T +44 (0) 1865 248045  
E oxford@adp-architecture.com  
www.adp-architecture.com

JOB TITLE:  
**GEORGE STREET  
REFURBISHMENT**




DRAWING TITLE:  
**GENERAL ARRANGEMENT - GROUND FLOOR**

SCALE: <b>1 : 100</b>	DRAWING SHEET SIZE: <b>A3</b>	
JOB CODE: <b>GSR</b>	DRAWING NUMBER: <b>ADP-00-00-DR- A-1026</b>	REVISION: <b>CR C9</b>

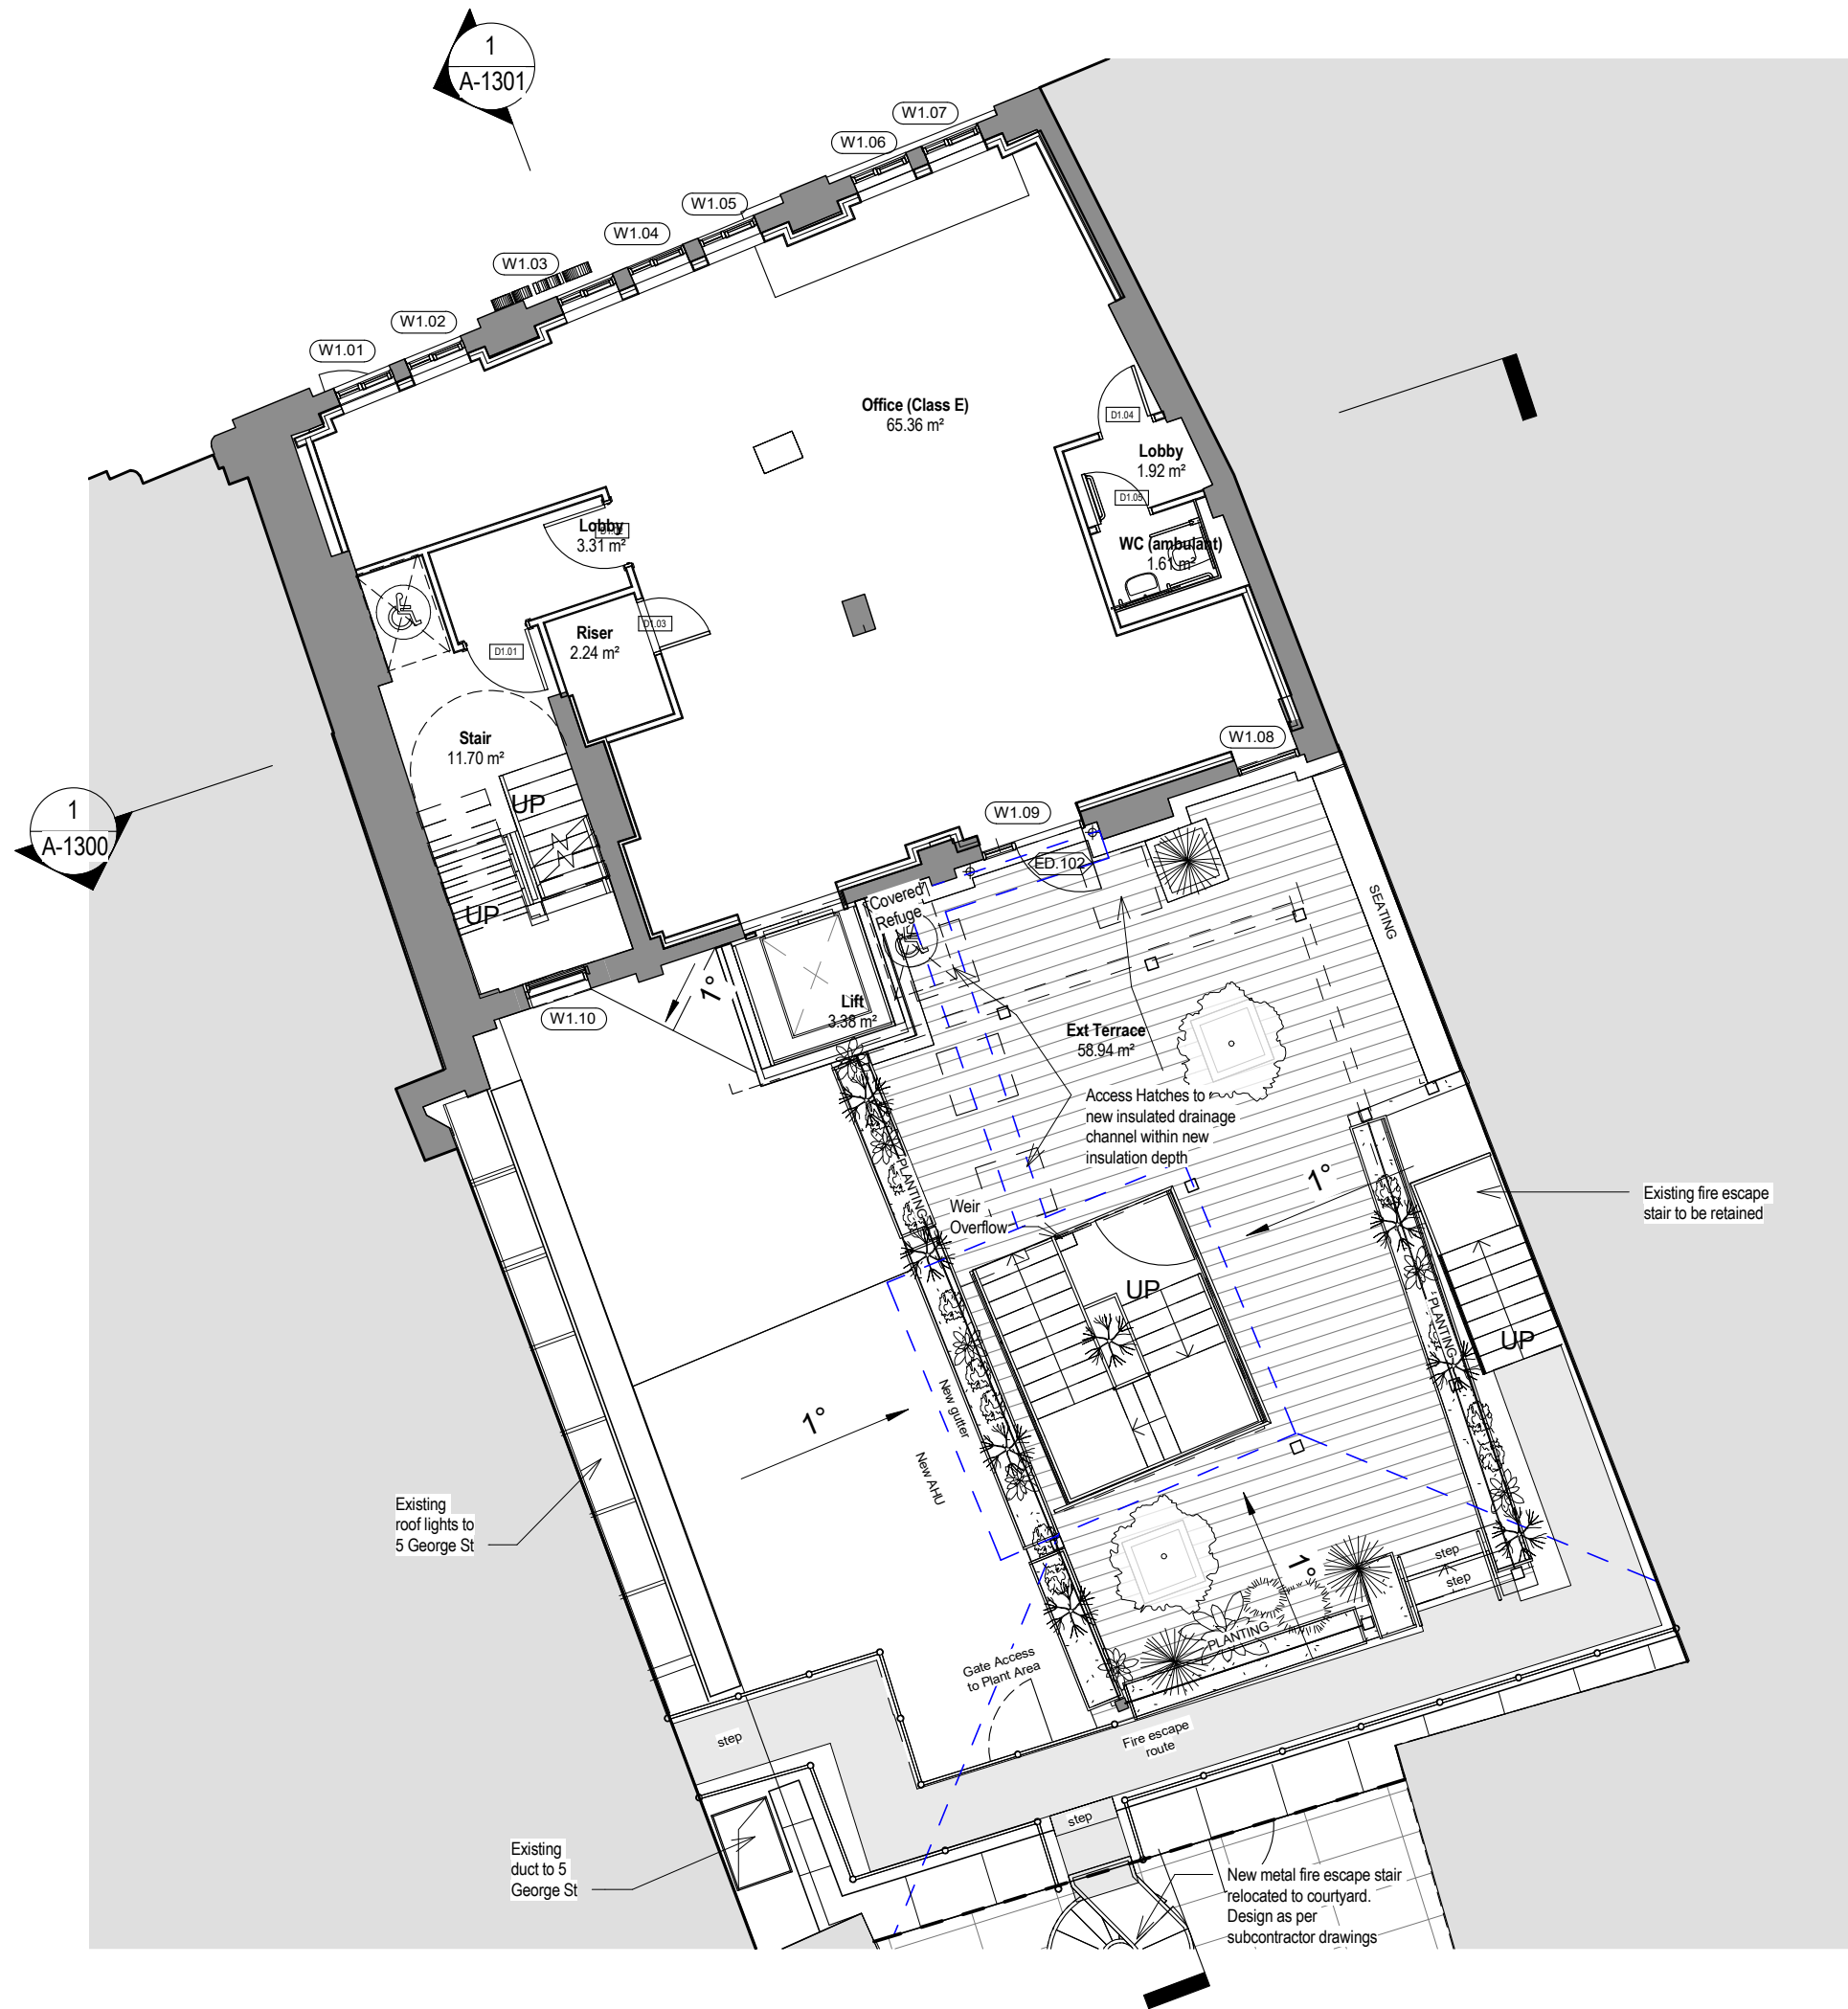

**NOTE:**  
 RECORD DRAWINGS WILL ONLY REFLECT FORMAL CHANGES TO THE DESIGN DURING CONSTRUCTION, TO REPRESENT MAIN CONTRACTOR DESIGN, AND NOT NECESSARILY TO BE DEEMED AS BUILT INFORMATION. RECORD DRAWINGS REPRESENT ARCHITECTURAL INFORMATION ONLY AND FOR FURTHER INFORMATION, THE RELEVANT CONSULTANTS RECORD DRAWINGS SHOULD BE REFERRED TO.

1. ALL DIMENSIONS IN MM UNLESS OTHERWISE STATED. DO NOT SCALE OFF DRAWING
2. PRINT IN COLOUR
3. BACKGROUND INFORMATION BASED ON SURVEY INFORMATION BY TERRA MEASUREMENT - 1534\_GEORGE, OXFORD\_REV\_A, 1534\_GEORGE\_STREET\_FLOOR\_PLANS
4. PARTY WALLS SHOWN INDICATIVELY

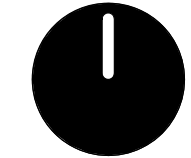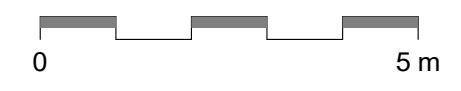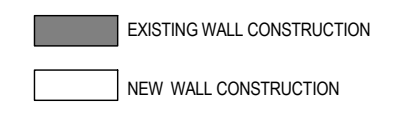

REVISION	DATE	DESCRIPTION	ARCHITECT	PARTNER
S2 P 2	23.06.20	Stage 2	GM	ADP
S2 P 3	31.07.20	Issued For Information	GM	ADP
S2 P 4	31.08.20	Stage 3 Update	GM	ADP
S2 P 5	22.09.20	Stage 3 Update	GM	ADP
S2 P 6	02.11.20	Tender Issue	GM	ADP
S2 P 7	04.12.20	Tender Issue	GM	ADP
S2 C 8	13.04.21	Construction Issue	RG	ADP
S2 C 9	30.12.21	Revised to include site requests / CVIs	RG	ADP
S2 C 10	15.04.22	Falls updated to reflect civils info	RG	ADP
CR C 11	31.03.23	CONSTRUCTION RECORD	RG	ADP

CHECK ALL DIMENSIONS AND VERIFY ON SITE. REPORT ANY ERRORS OR OMISSIONS

### CONSTRUCTION RECORD


Cantay House  
 Park End Street, Oxford, OX1 1JD  
 T +44 (0) 1865 248045  
 E oxford@adp-architecture.com  
 www.adp-architecture.com

**JOB TITLE:**  
 GEORGE STREET  
 REFURBISHMENT

**DRAWING TITLE:**  
 GENERAL ARRANGEMENT - FIRST FLOOR

**SCALE:** 1 : 100      **DRAWING SHEET SIZE:** A3

**JOB CODE:** GSR      **DRAWING NUMBER:** ADP-00-01-DR- A-1027      **REVISION:** CR C 11

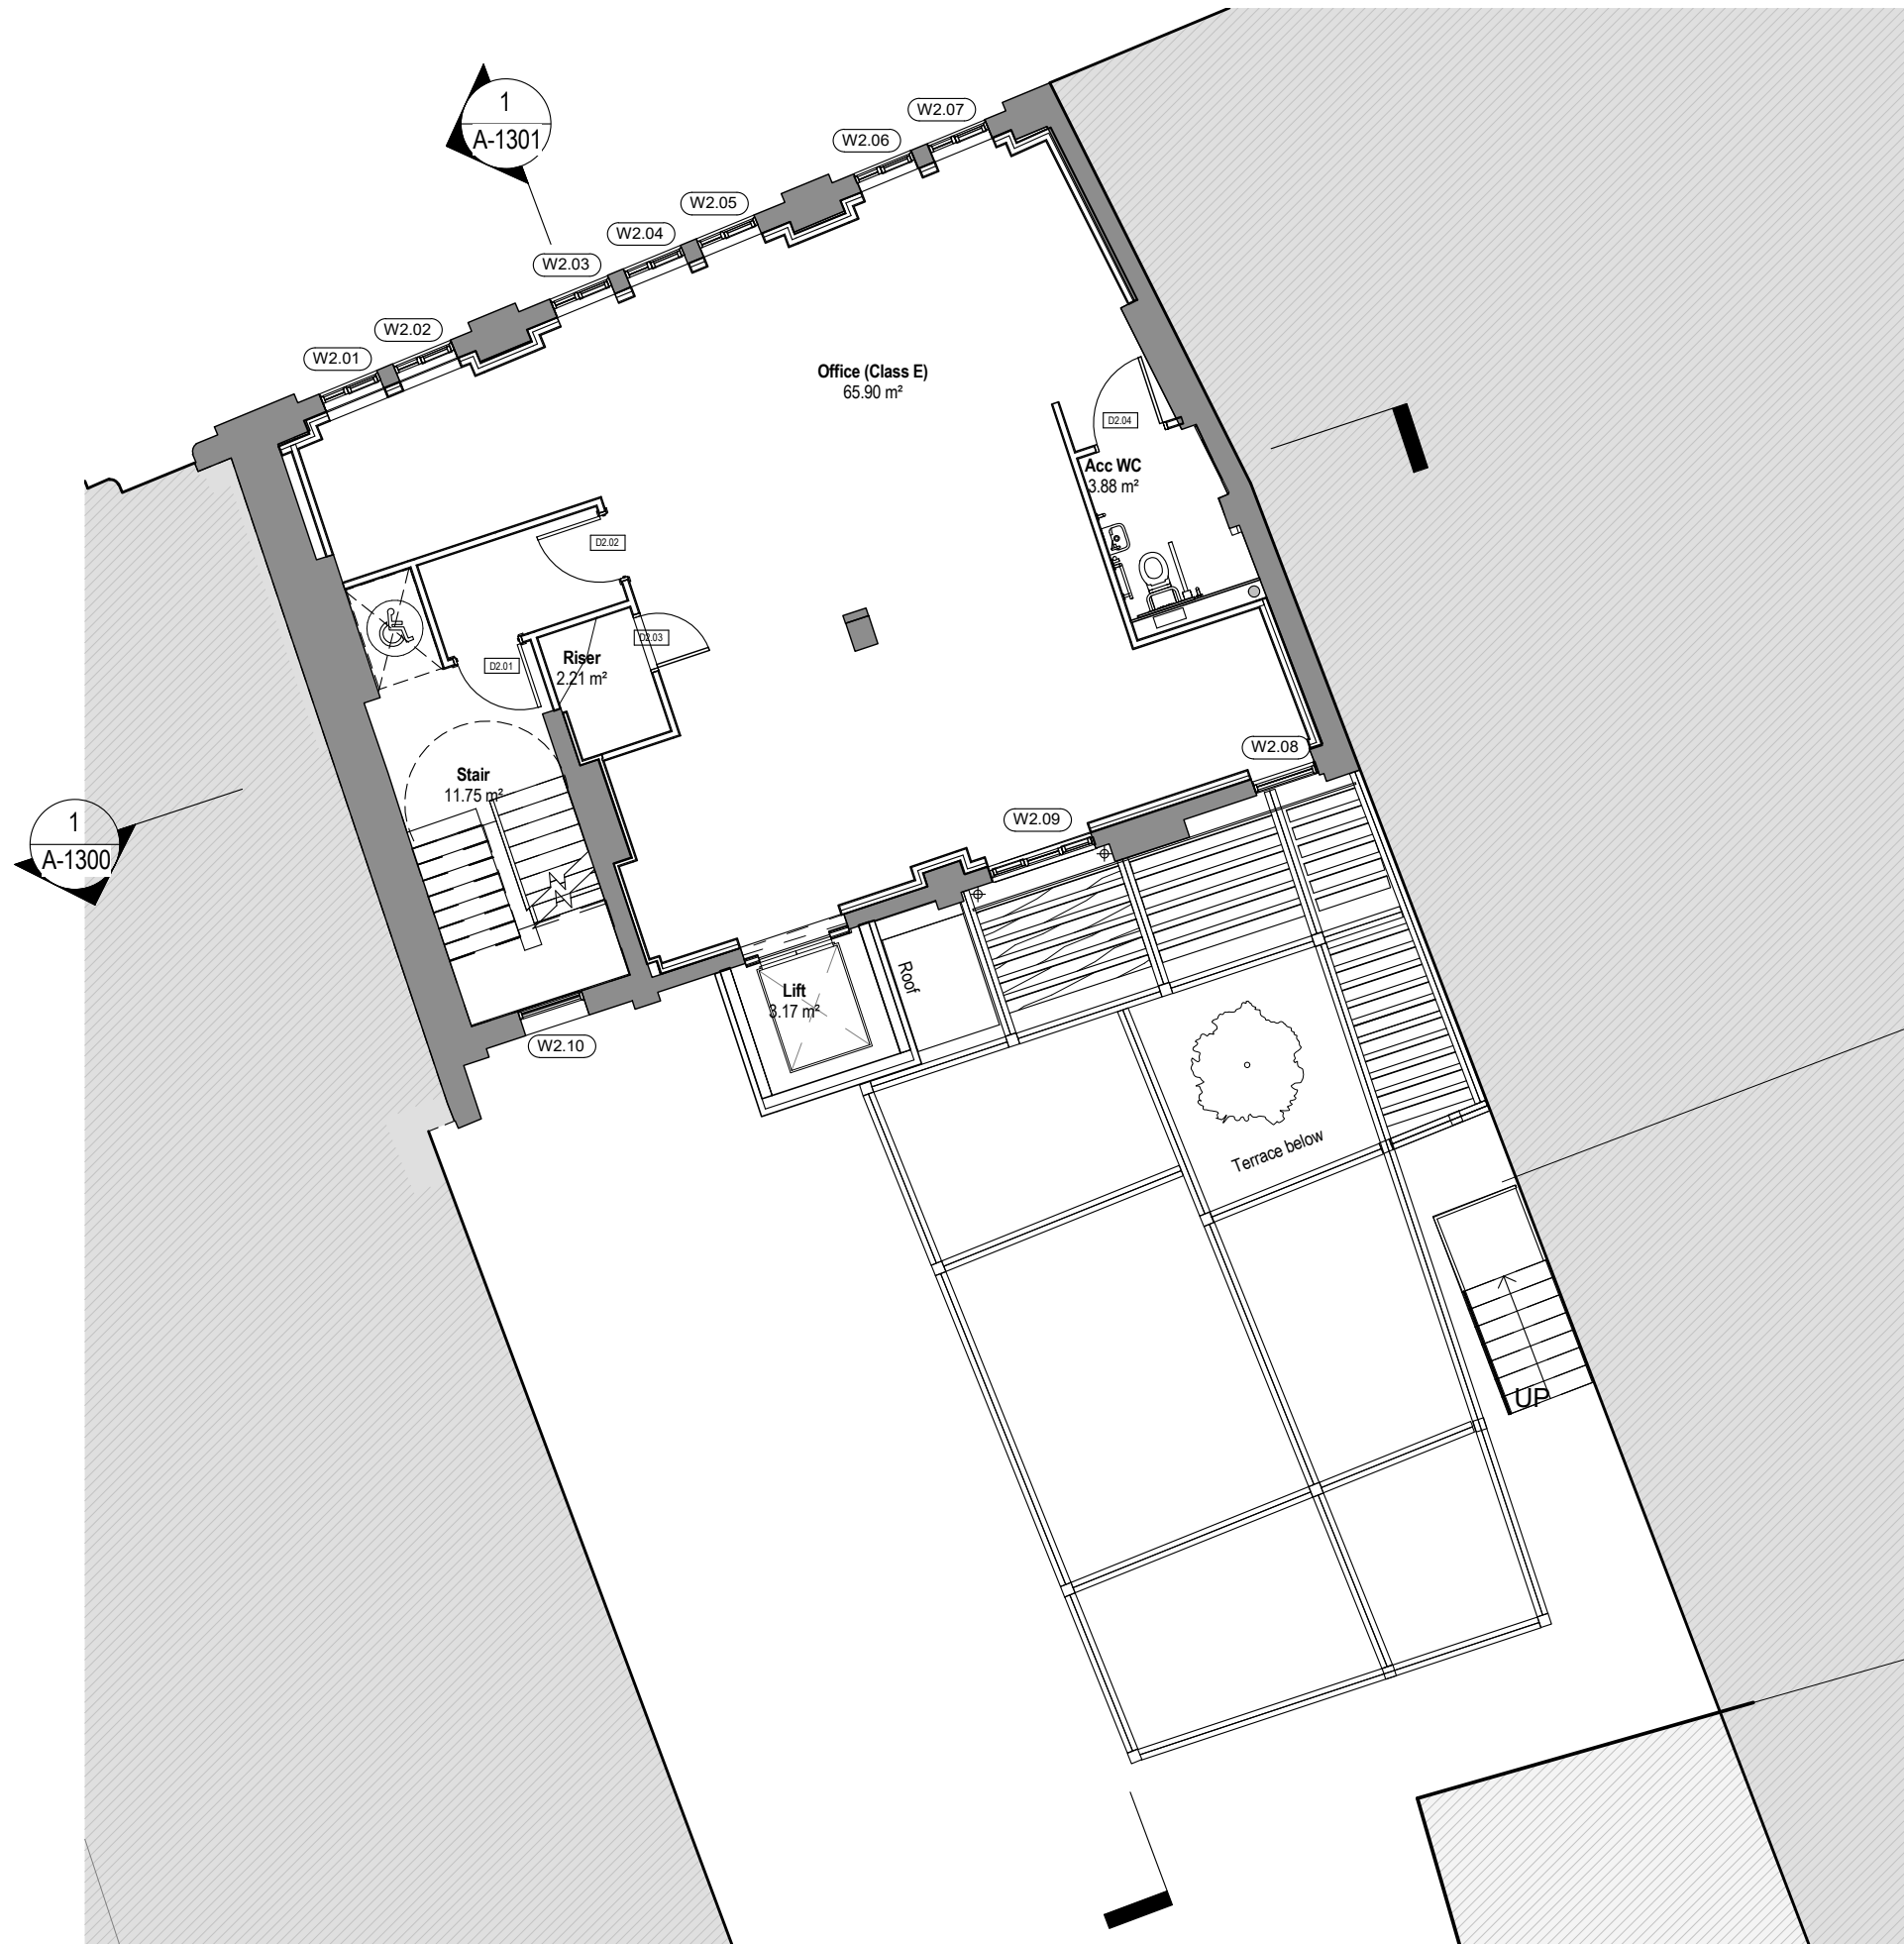

**NOTE:**


RECORD DRAWINGS WILL ONLY REFLECT FORMAL CHANGES TO THE DESIGN DURING CONSTRUCTION, TO REPRESENT MAIN CONTRACTOR DESIGN, AND NOT NECESSARILY TO BE DEEMED AS BUILT INFORMATION. RECORD DRAWINGS REPRESENT ARCHITECTURAL INFORMATION ONLY AND FOR FURTHER INFORMATION, THE RELEVANT CONSULTANTS RECORD DRAWINGS SHOULD BE REFERRED TO.

1. ALL DIMENSIONS IN MM UNLESS OTHERWISE STATED. DO NOT SCALE OFF DRAWING


2. PRINT IN COLOUR

3. BACKGROUND INFORMATION BASED ON SURVEY INFORMATION BY TERRA MEASUREMENT - 1534\_GEORGE, OXFORD\_REV\_A, 1534 \_GEORGE\_STREET\_FLOOR\_PLANS

4. PARTY WALLS SHOWN INDICATIVELY

 EXISTING WALL CONSTRUCTION

 NEW WALL CONSTRUCTION

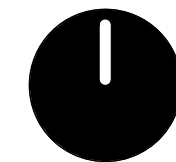

REVISION	DATE	DESCRIPTION	ARCHITECT	PARTNER
S2 P 1	10.06.20	Issued For Information	GM	ADP
S2 P 2	23.06.20	Stage 2	GM	ADP
S2 P 3	31.07.20	Issued For Information	GM	ADP
S2 P 4	31.08.20	Stage 3 Update	GM	ADP
S2 P 5	22.09.20	Stage 3 Update	GM	ADP
S2 P 6	02.11.20	Tender Issue	GM	ADP
S2 P 7	04.12.20	Tender Issue	GM	ADP
S2 C 8	13.04.21	Construction Issue	RG	ADP
S2 C 9	30.12.21	Revised to include site requests / CVIs	RG	ADP
CR C 10	31.03.23	CONSTRUCTION RECORD	RG	ADP

CHECK ALL DIMENSIONS AND VERIFY ON SITE. REPORT ANY ERRORS OR OMISSIONS

**CONSTRUCTION RECORD**




Cantay House  
 Park End Street, Oxford OX1 1JD  
 T +44 (0) 1865 248045  
 E oxford@adp-architecture.com  
 www.adp-architecture.com

JOB TITLE:  
**GEORGE STREET  
 REFURBISHMENT**

DRAWING TITLE:  
**GENERAL ARRANGEMENT - SECOND FLOOR**

SCALE: **1 : 100**      DRAWING SHEET SIZE: **A3**

JOB CODE: **GSR**      DRAWING NUMBER: **ADP-00-02-DR- A-1028**      REVISION: **CR C 10**

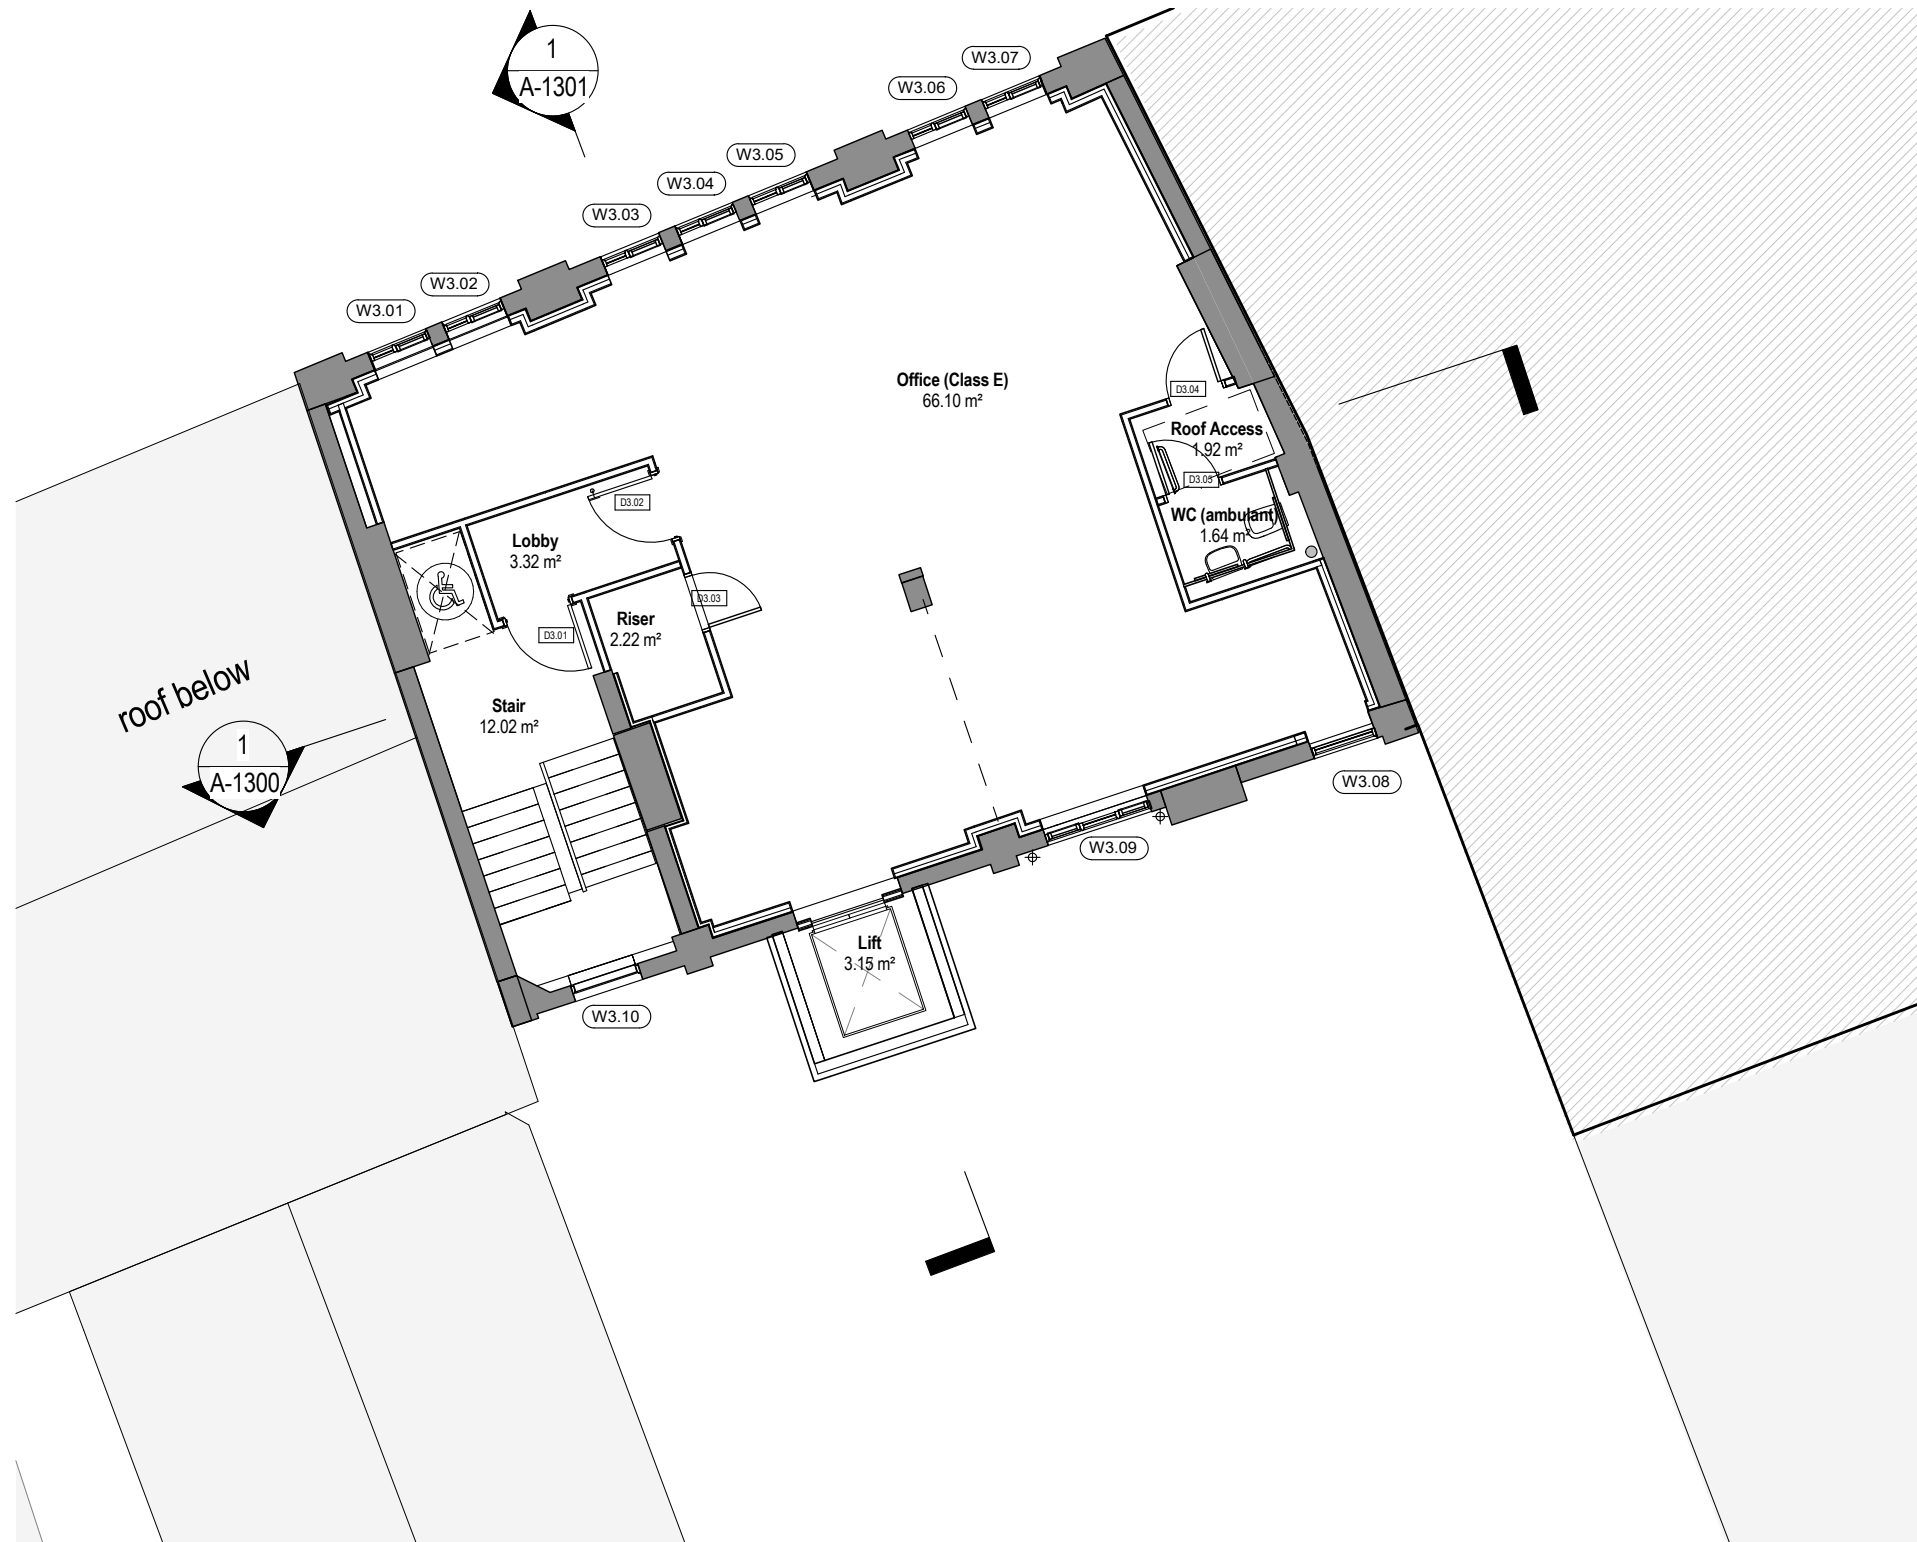


**NOTE:**

RECORD DRAWINGS WILL ONLY REFLECT FORMAL CHANGES TO THE DESIGN DURING CONSTRUCTION, TO REPRESENT MAIN CONTRACTOR DESIGN, AND NOT NECESSARILY TO BE DEEMED AS BUILT INFORMATION. RECORD DRAWINGS REPRESENT ARCHITECTURAL INFORMATION ONLY AND FOR FURTHER INFORMATION, THE RELEVANT CONSULTANTS RECORD DRAWINGS SHOULD BE REFERRED TO.

1. ALL DIMENSIONS IN MM UNLESS OTHERWISE STATED. DO NOT SCALE OFF DRAWING
2. PRINT IN COLOUR
3. BACKGROUND INFORMATION BASED ON SURVEY INFORMATION BY TERRA MEASUREMENT - 1534\_GEORGE, OXFORD\_REV\_A, 1534\_GEORGE\_STREET\_FLOOR\_PLANS
4. PARTY WALLS SHOWN INDICATIVELY

EXISTING WALL CONSTRUCTION  
 NEW WALL CONSTRUCTION

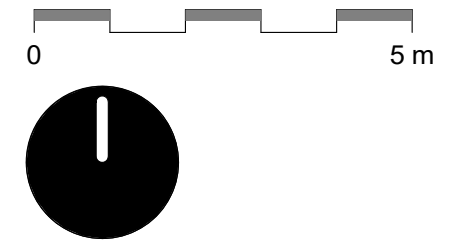

REVISION	DATE	DESCRIPTION	ARCHITECT	PARTNER
S2 P 1	10.06.20	Issued For Information	GM	ADP
S2 P 2	23.06.20	Stage 2	GM	ADP
S2 P 3	31.07.20	Issued For Information	GM	ADP
S2 P 4	31.08.20	Stage 3 Update	GM	ADP
S2 P 5	22.09.20	Stage 3 Update	GM	ADP
S2 P 6	02.11.20	Tender Issue	GM	ADP
S2 P 7	04.12.20	Tender Issue	GM	ADP
S2 C 8	13.04.21	Construction Issue	RG	ADP
S2 C 9	30.12.21	Revised to include site requests / CVIs	RG	ADP
CR C 10	31.03.23	CONSTRUCTION RECORD	RG	ADP

CHECK ALL DIMENSIONS AND VERIFY ON SITE. REPORT ANY ERRORS OR OMISSIONS

**CONSTRUCTION RECORD**

Cantay House  
 Park End Street, Oxford OX1 1JD  
 T +44 (0) 1865 248045  
 E oxford@adp-architecture.com  
 www.adp-architecture.com

**JOB TITLE:**  
GEORGE STREET  
REFURBISHMENT

**DRAWING TITLE:**  
GENERAL ARRANGEMENT - THIRD FLOOR

<b>SCALE:</b> 1 : 100	<b>DRAWING SHEET SIZE:</b> A3
<b>JOB CODE:</b> GSR	<b>DRAWING NUMBER:</b> ADP-00-03-DR- A-1029
<b>REVISION:</b> CR C 10	