



CROWN DILMUN HOUSING

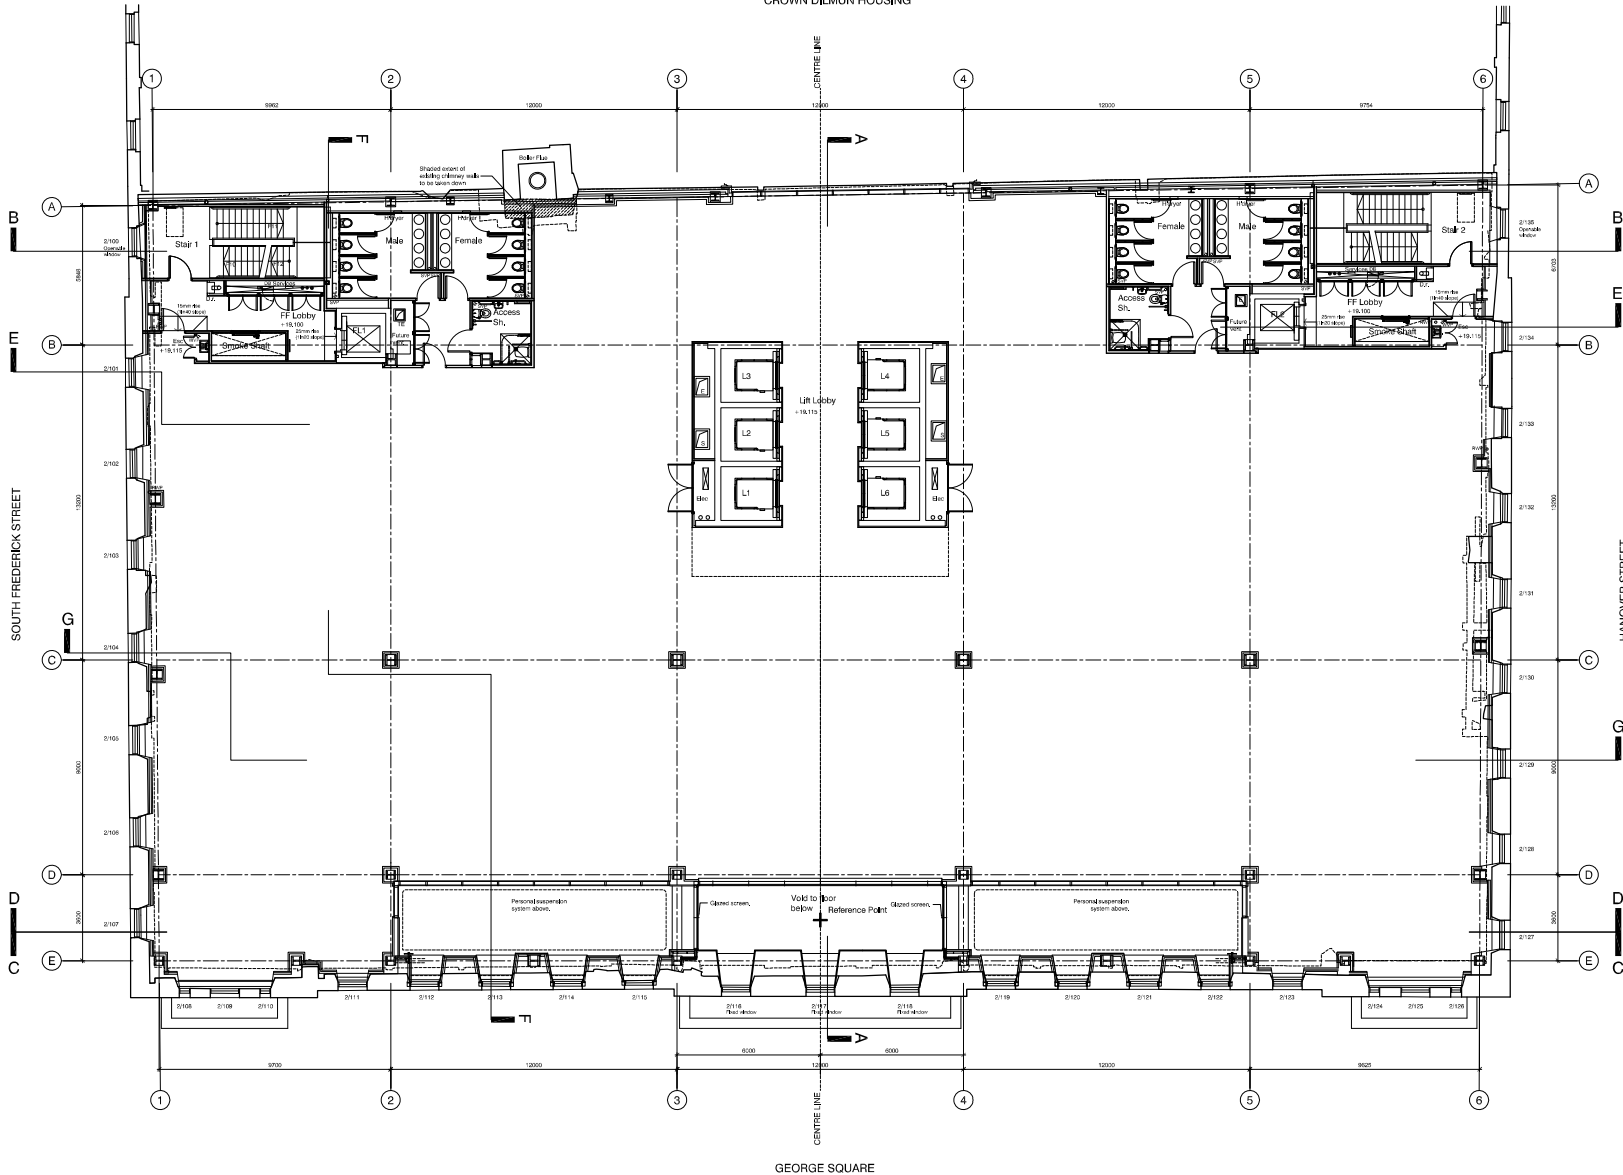

SECOND FLOOR PLAN

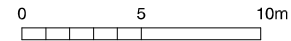

Notes:
 The contractor is to check the site and check all dimensions and levels before commencing work. No variations should be made without reference to the architect. No dimensions should be taken from the drawings.

Cooper Cromar

Architects: Glasgow, Edinburgh
 Group Office: 47 South Hill Street, Glasgow G2 3JZ
 Main Office: 25 Hanover Street, Glasgow G2 6DU
 City Office: 100 George Street, Glasgow G2 2JL
 Project Coordinator: T 0141 302 2810, F 011 302 2819, www.cooper-cromar.com

AS BUILT	
© DRAGON DEVELOPMENTS (G1) LIMITED	
Project No: No. 1, GLASGOW GEORGE SQUARE GLASGOW	
Drawing No: SECOND FLOOR PLAN AS PROPOSED	
Scale: 1:100 @ A1 Drawn by: SEW	Date: MAY 2007 Checked by: GT
Rev. No. 02011	Rev. No. AL(0)37
Rev. AC	