

Notes:


Contractors must check all dimensions prior to the commencement of the contract. Any discrepancies must be reported to the project co-ordinator before proceeding with the contract.


All dimensions and sizes are in millimetres unless otherwise stated.

No part of this drawing may be reproduced, stored in any retrieval system or transmitted in any form without prior permission of The Open University Estates Department.

Rev	Date	Description	By	Chk'd

First Floor

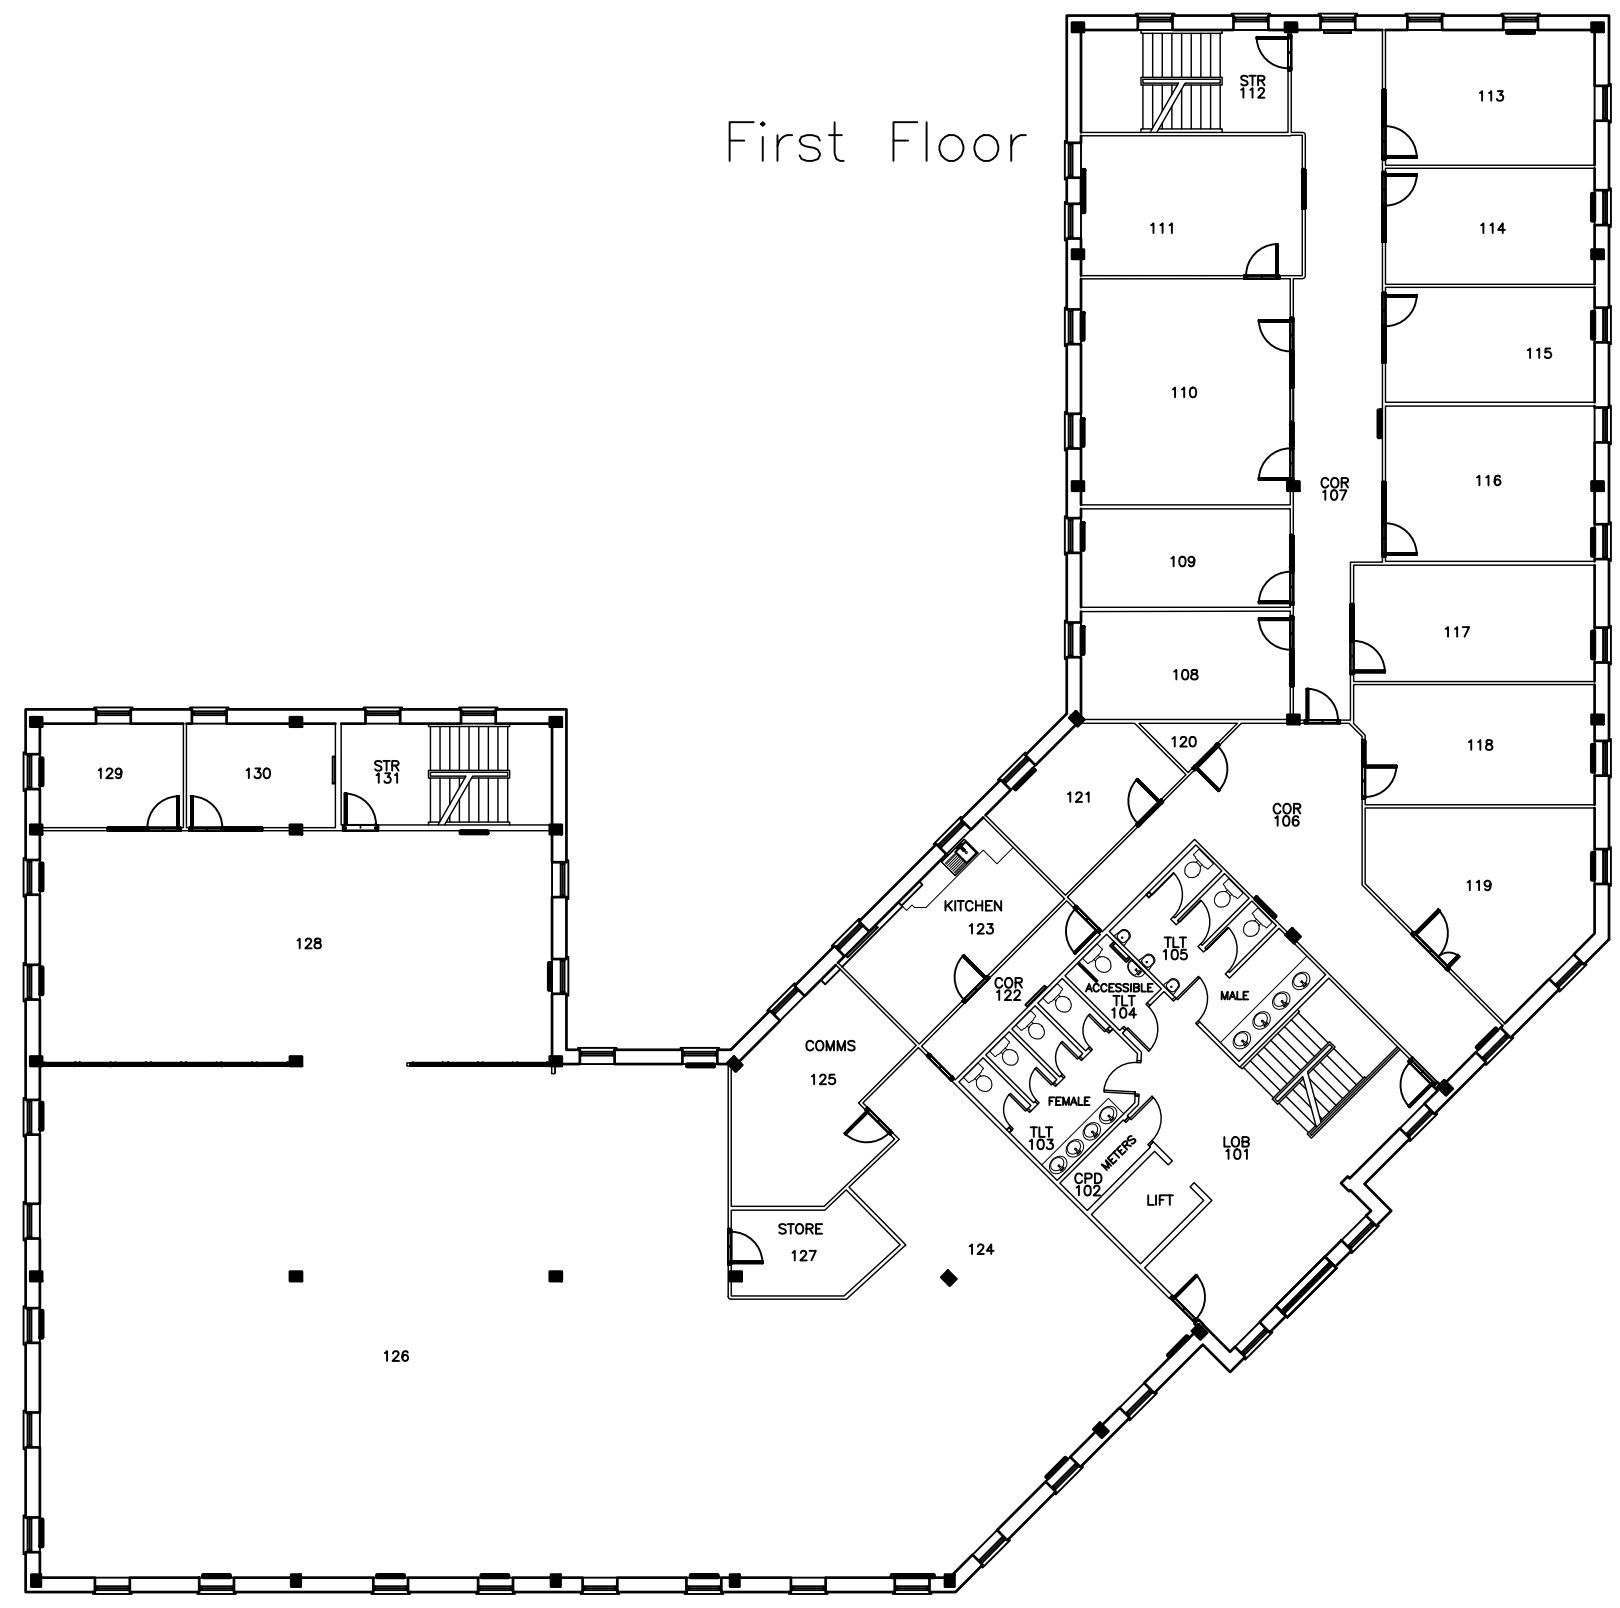

 Estates Division Walton Hall Milton Keynes MK7 6AA Tel: 01908 653826	
Drawing Status As Built	
Project ref / no	Discipline
-	Floor Plan
Building Name	Building No
-	-
Floor	Site
Ground Floor	R05 - Nottingham
Drawing description	
Updated Floor Plan - Surveyed January 2013	
Revision	Date
A-01	October 2014
Drawn / updated By	Scale
E.Noble	1 : 100 @ A1
Drawing number or file name	
R05-R05NOTB-00-B100-052-A-01	