


This drawing is protected by the Design Copyright Act 1968 and may not be copied or reproduced without consent.

Do not scale from this drawing. Dimensions are to be confirmed on site and subject to building control and statutory approvals.

Dimensions shown on these drawings are based on the best information available at the time of site check. If in doubt ask.

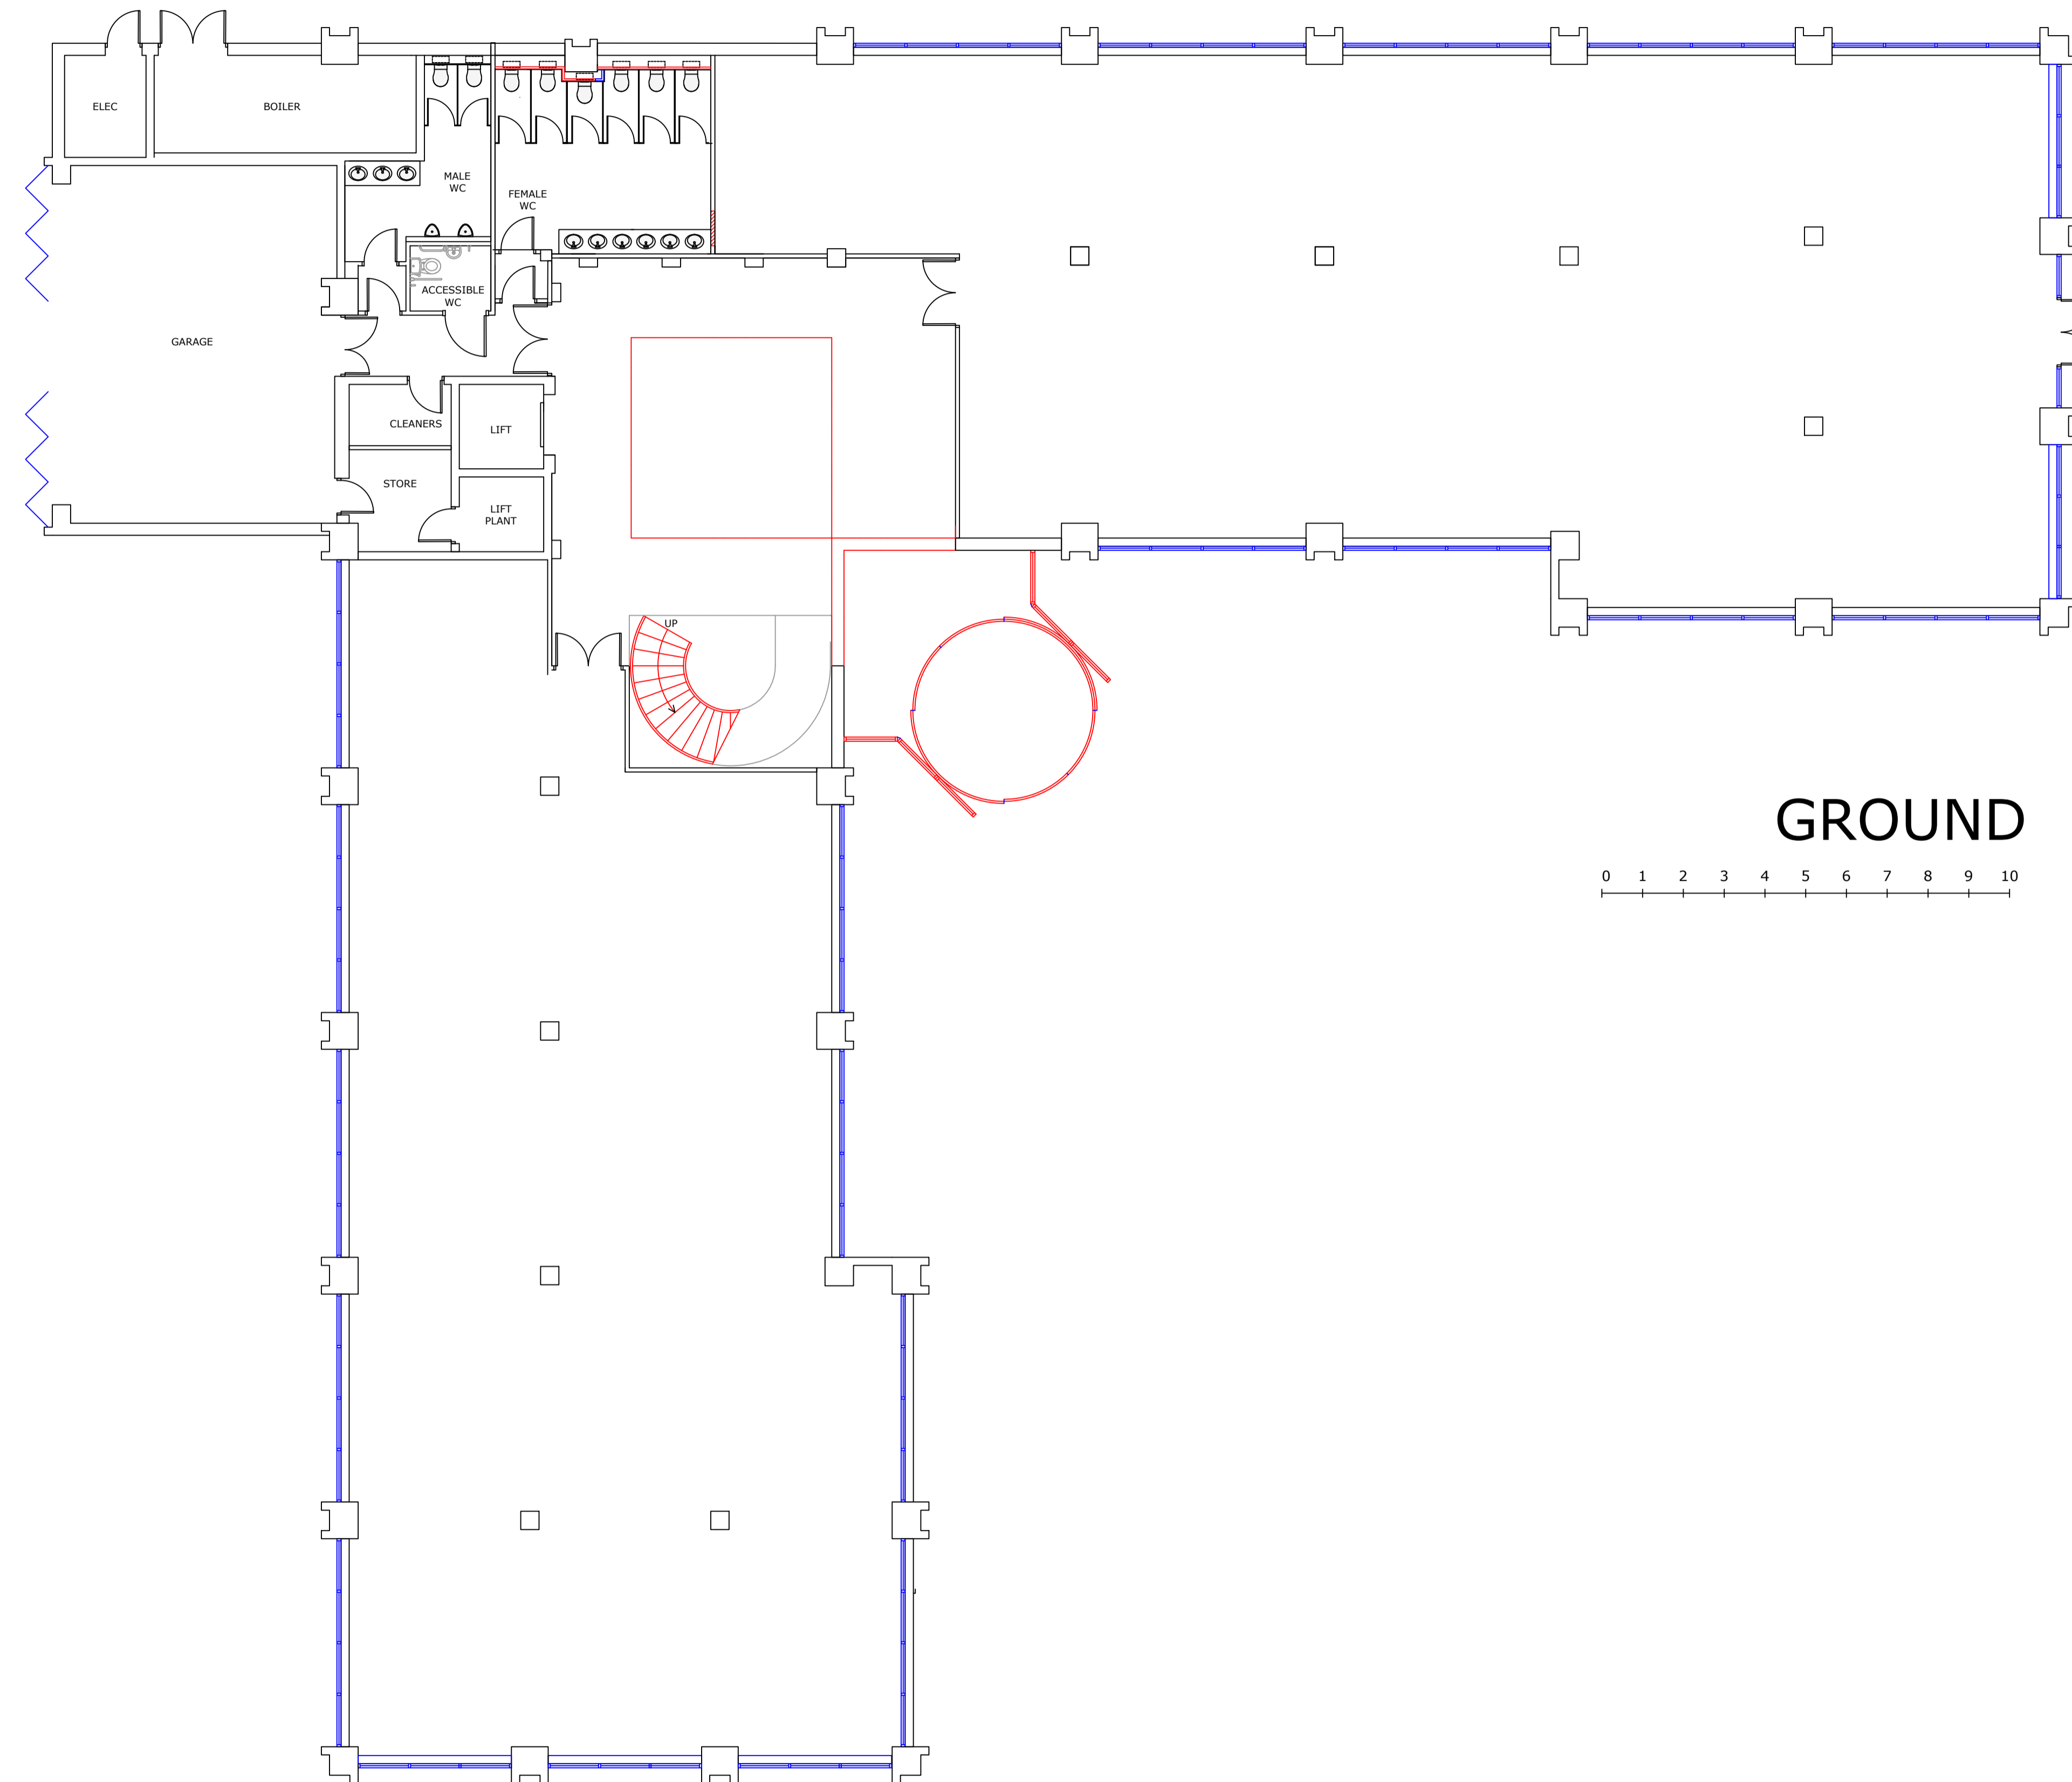

Storage Heights	1500 mm
750 mm	2000 mm
1000 mm	Storage wall

Approved

Date

Checked

Date

Rev	Date	Description
A	03.07.24	Female WC layout updated
B	29.07.24	Drawing updated to as built

IntexProjects

Hawkestone House
Portland Mews
Leamington Spa
CV32 5HD
T: 01926 424 656
F: 01926 424 655
www.intexprojects.com

Preliminary Information
Tender Contract
Construction As Built ★

Client **KWB**

Location **2610 THE CRESCENT**

Level **GROUND**

Title **GENERAL ARRANGEMENT**


Dwg no **P4873- CR - 00 - 03**

Scale 1:100 @ A1 Drawn EB
Date 04.05.24 Revision B
Survey -

This drawing is protected by the Design Copyright Act 1968 and may not be copied or reproduced without consent.

Do not scale from this drawing. Dimensions are to be confirmed on site and subject to building control and statutory approvals.

Dimensions shown on these drawings are based on the best information available at the time of site check. If in doubt ask.

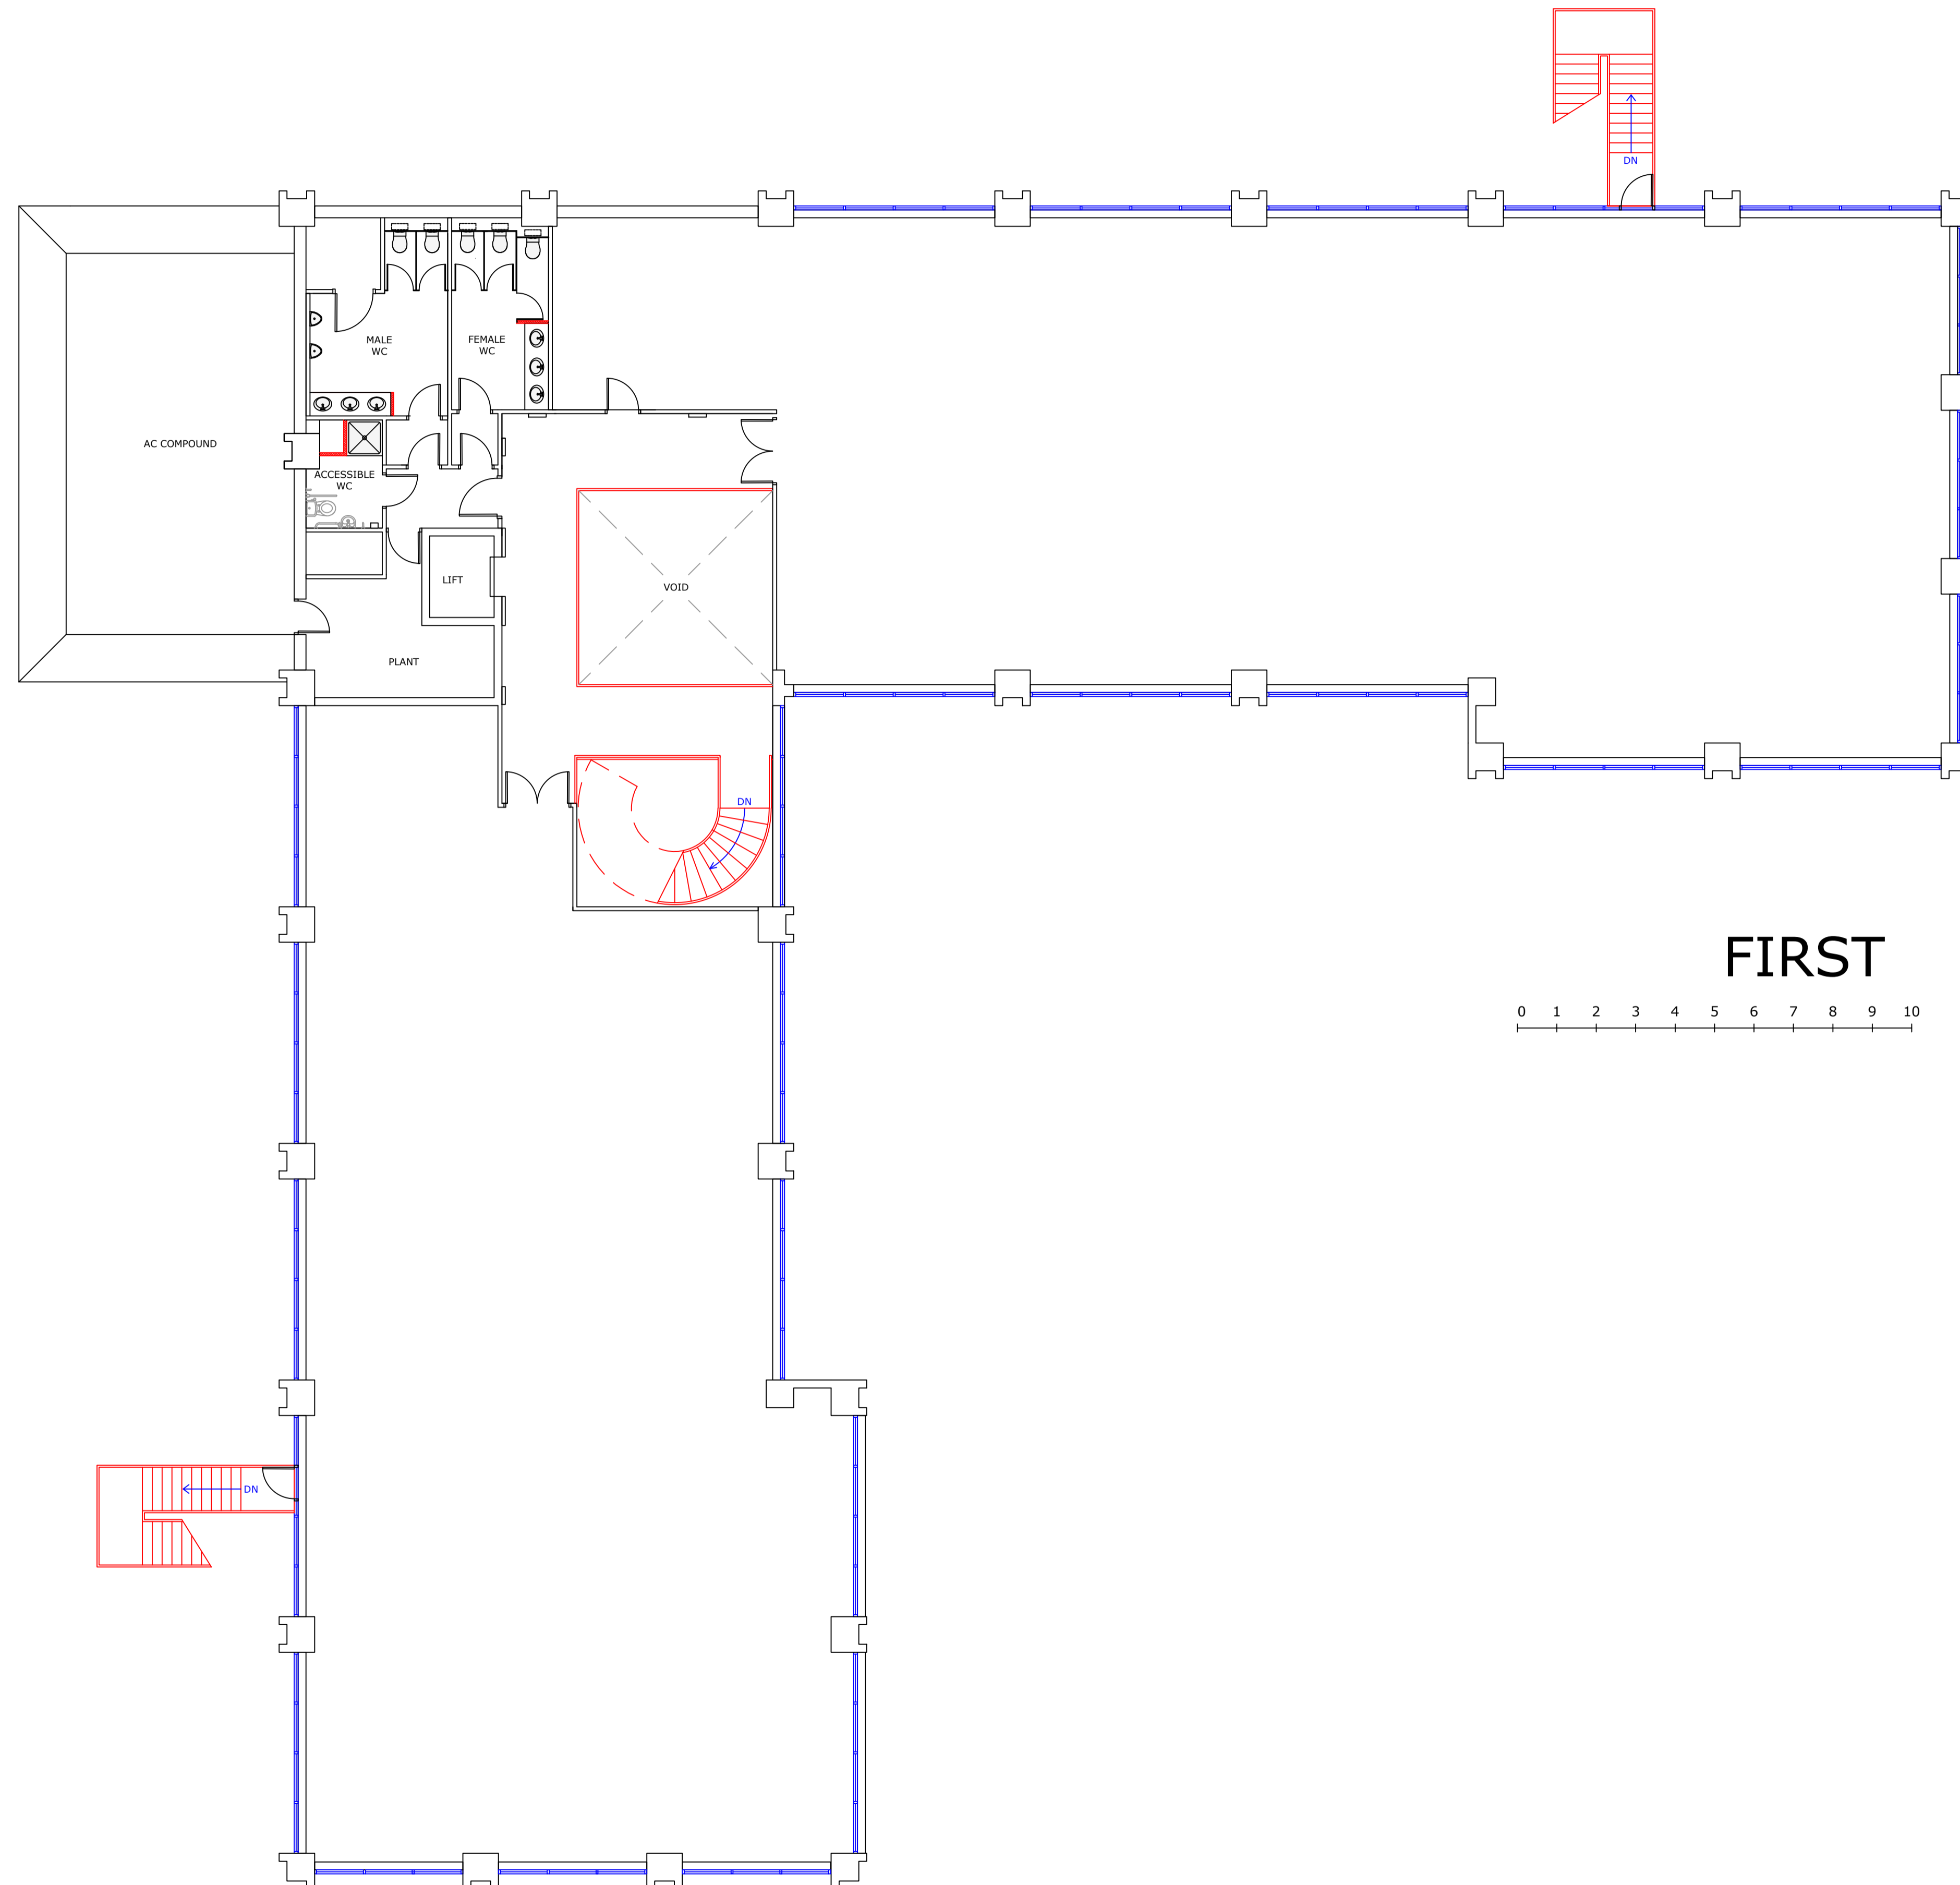

Storage Heights	1500 mm
750 mm	2000 mm
1000 mm	Storage wall

Approved

Date

Checked

Date

Rev	Date	Description
A	04.04.24	WC's and reception lobby surveyed
B	29.07.24	Drawing updated to as built

IntexProjects

Hawkestone House
Portland Mews
Leamington Spa
CV32 5HD
T: 01926 424 656
F: 01926 424 655
www.intexprojects.com

Preliminary Information
Tender Contract
Construction As Built ★

Client
KWB

Location
2610 THE CRESCENT

Level
FIRST

Title
GENERAL ARRANGEMENT

Dwg no
P4873 - CR - 01 - 03

Scale	1:100 @ A1	Drawn	EB
Date	04.06.24	Revision	B
		Survey	-