


First Floor

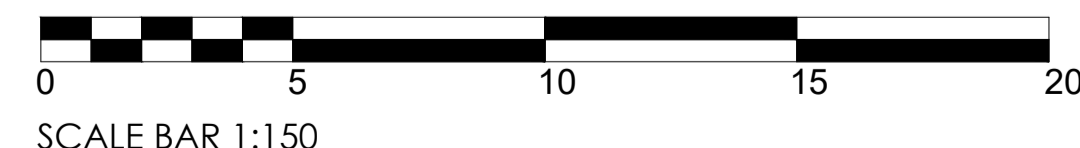

SCALE BAR 1:150

This drawing is protected by the Design Copyright Act 1968 and may not be copied or reproduced without consent.

All dimensions, setting out and levels must be checked on site and not to be scaled off of this drawing prior to ordering & starting work on site.

Notes:

No new partitions
Drawing produced to clarify.

R1	26.09.23	JH	Construction issue	V
C1	12.06.23	JH	Construction issue	KS
B	13.01.23	SS	Sub tenancy walls removed as per conversation on 13.01.2023	KS
A	12.12.22	JH	First drawn	KS
Rev	Date	By	Description	Checked

STATUS: RECORD DRAWING



CLIENT: SHAKESPEARE MARTINEAU

SITE: NO1 COLMORE SQUARE

FLOOR: FIRST

DRAWING TYPE: PARTITION SETTING OUT & WALL TYPES

SCALE AT A1:	DATE:	DRAWN:	CHECKED:
1:150	12.12.2022	JH	KS
PROJECT REF:	DRAWING NUMBER:	REVISION:	
O12224	20-003	R1	

OFFICE INNOVATIONS
creating space for success

1-3 Factory Lane
Chilwell
Nottingham
NG9 4AA
Tel. 0115 925 7898
Fax. 0115 925 7899

Printed: