



NOTE - Responsibility is not accepted for errors made by others in scaling from this drawing. All construction information should be taken from figured dimensions only

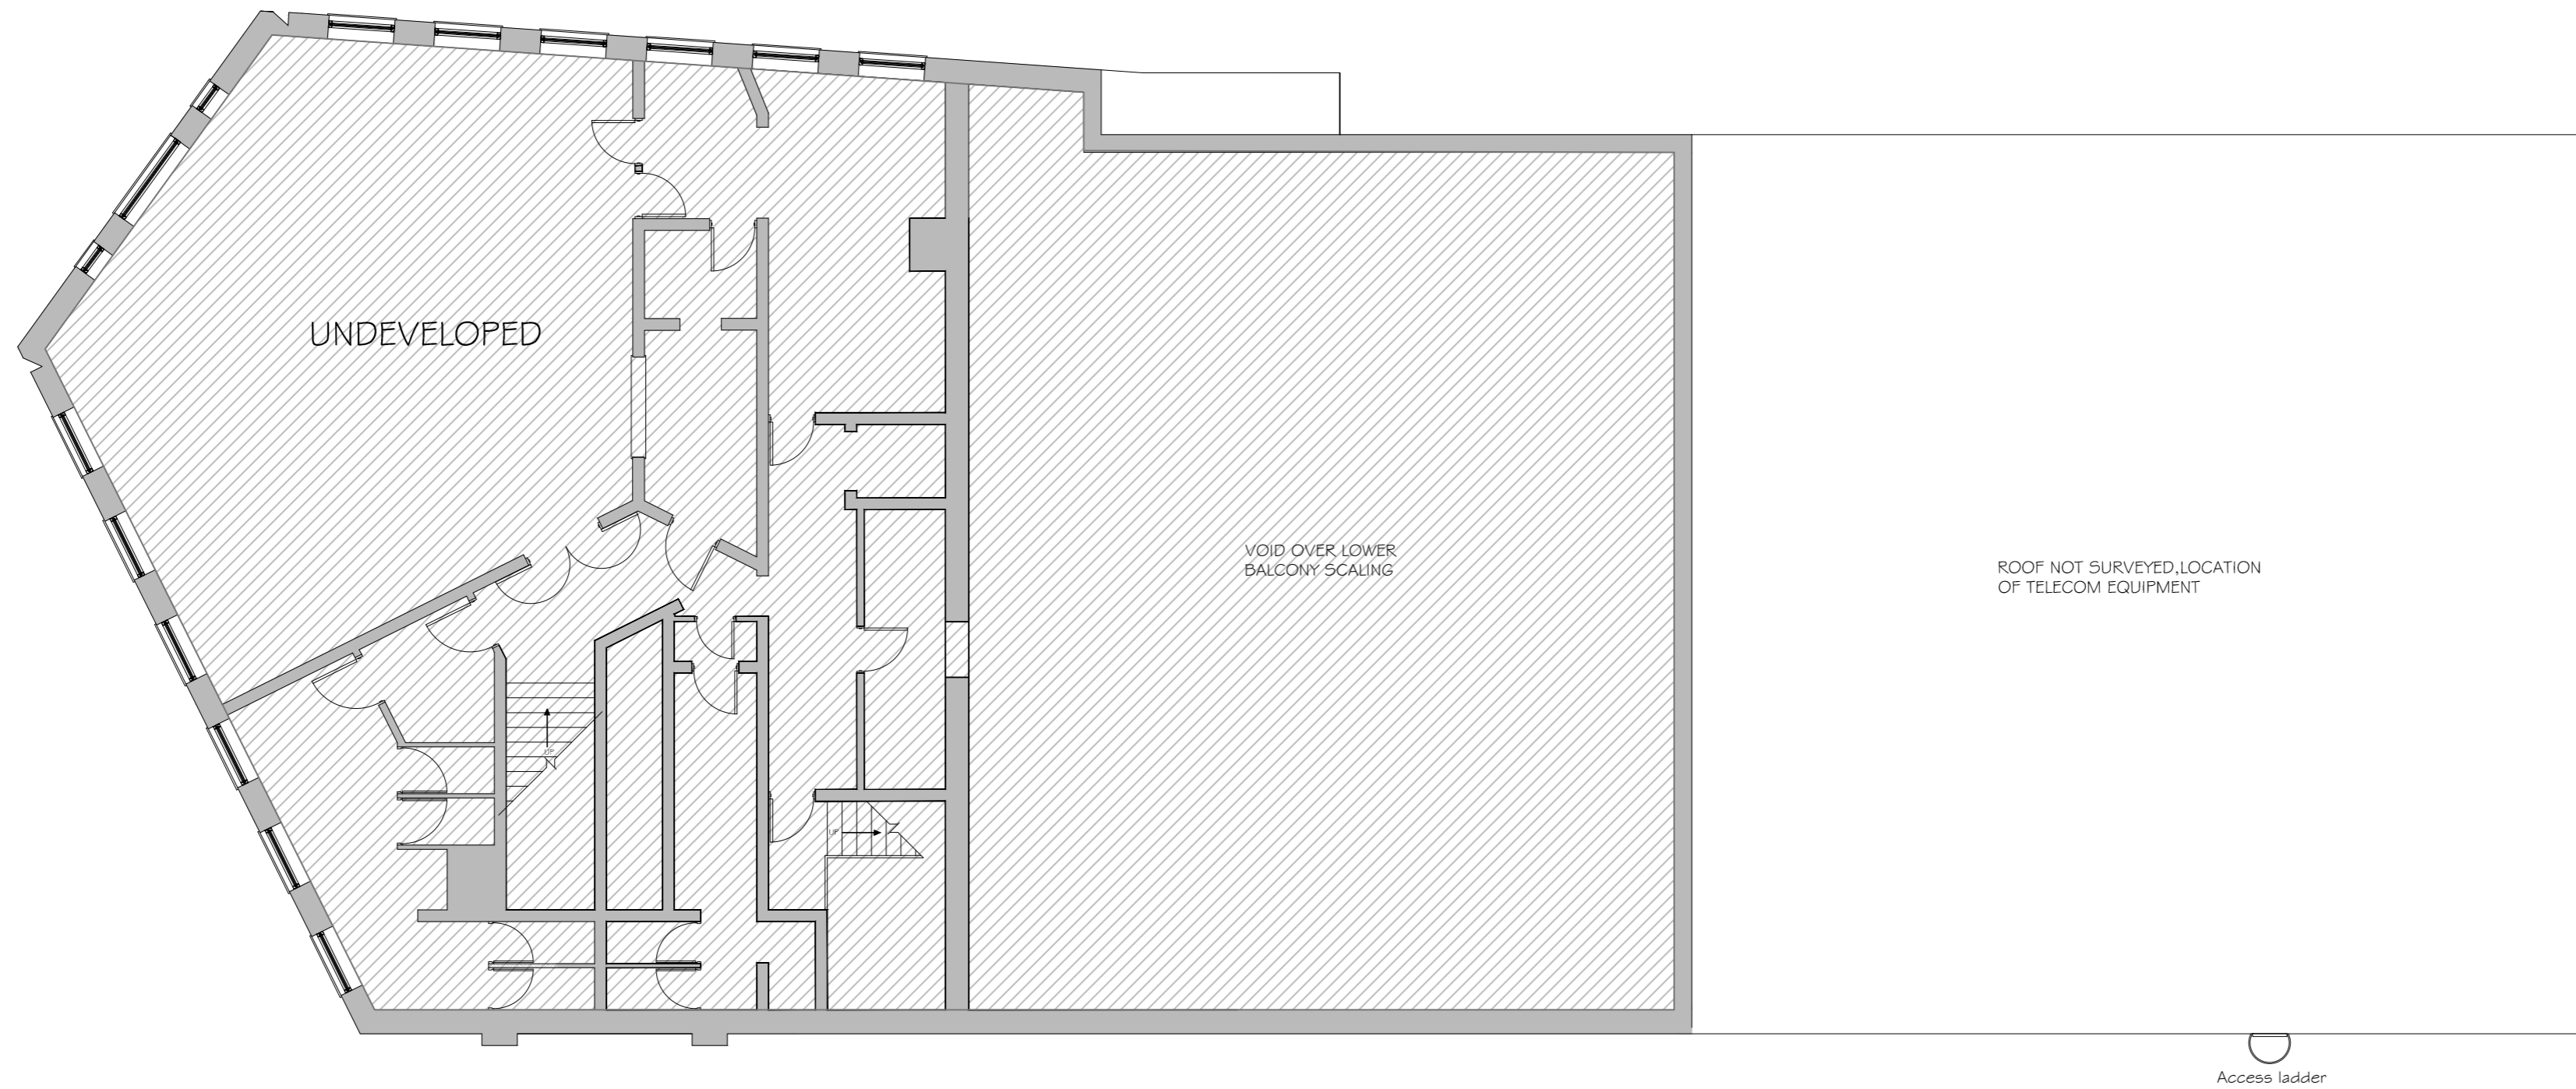

AS BUILT SECOND FLOOR

 UNDEVELOPED

AS BUILT ISSUE

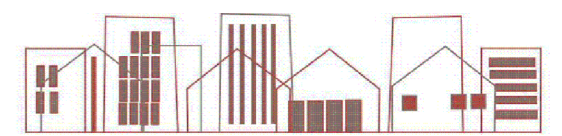

**K d paine & associates ltd**

architectural & construction consultants  
project managers interior designers

Adur Business Centre Little High Street,  
Shoreham by Sea, West Sussex, BN43 5EG.  
t: +44 (0)1273 467518 f: +44 (0)1273 467520  
e-mail: info@kdpaine.co.uk

CLIENT	JD WETHERSPOON PLC		
PROJECT	PUB NO: G527 THE REGENT KIRKBY IN ASHFIELD		
DRAWING	AS BUILT SECOND FLOOR GENERAL ARRANGEMENT		
SCALE	A3 : NT5 A2/ 1 : 100	DATE	FEB 2013
PROJECT No	6640	DRAWING No	09
DRAWN	AR, LM	REVISION	