



NAME: RIBBLE VALLEY INGS ADDRESS: THREE FLOORS BOTTOM WHARFLEY	
DRAWING NO: SITE PLAN	
DATE: 1.10.88	DRAWN BY: S.P.P.
SCALE: 1:100	SHEET NO: 140
PROJECTED BY: [Logo] PROJECTS & CONSULTANTS LTD. 10, ST. JOHN'S ROAD, LONDON W14 8JL TEL: 0181 873 7500 FAX: 0181 873 7501	
3350-16	

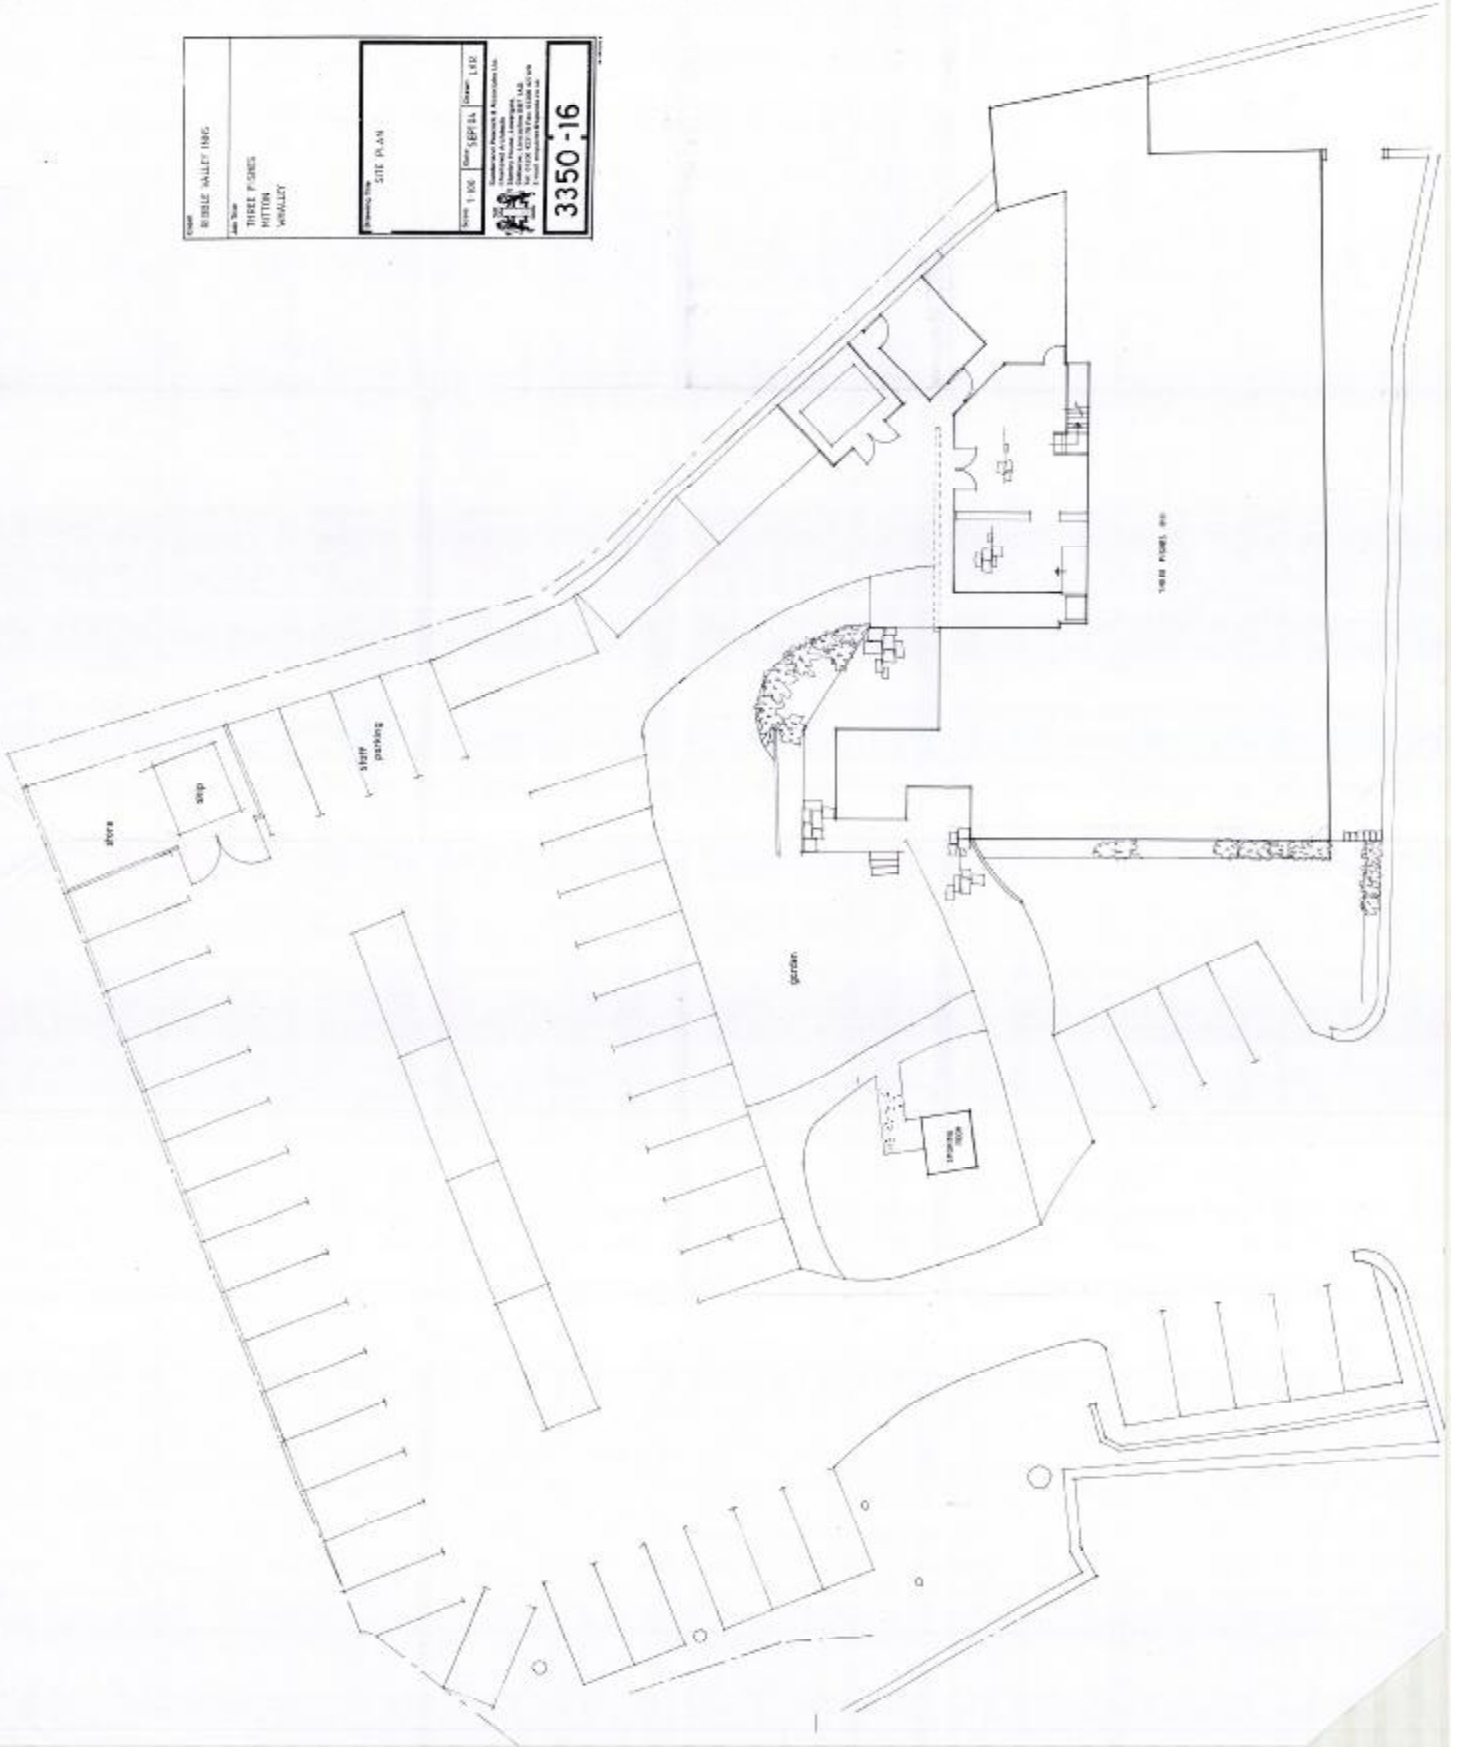

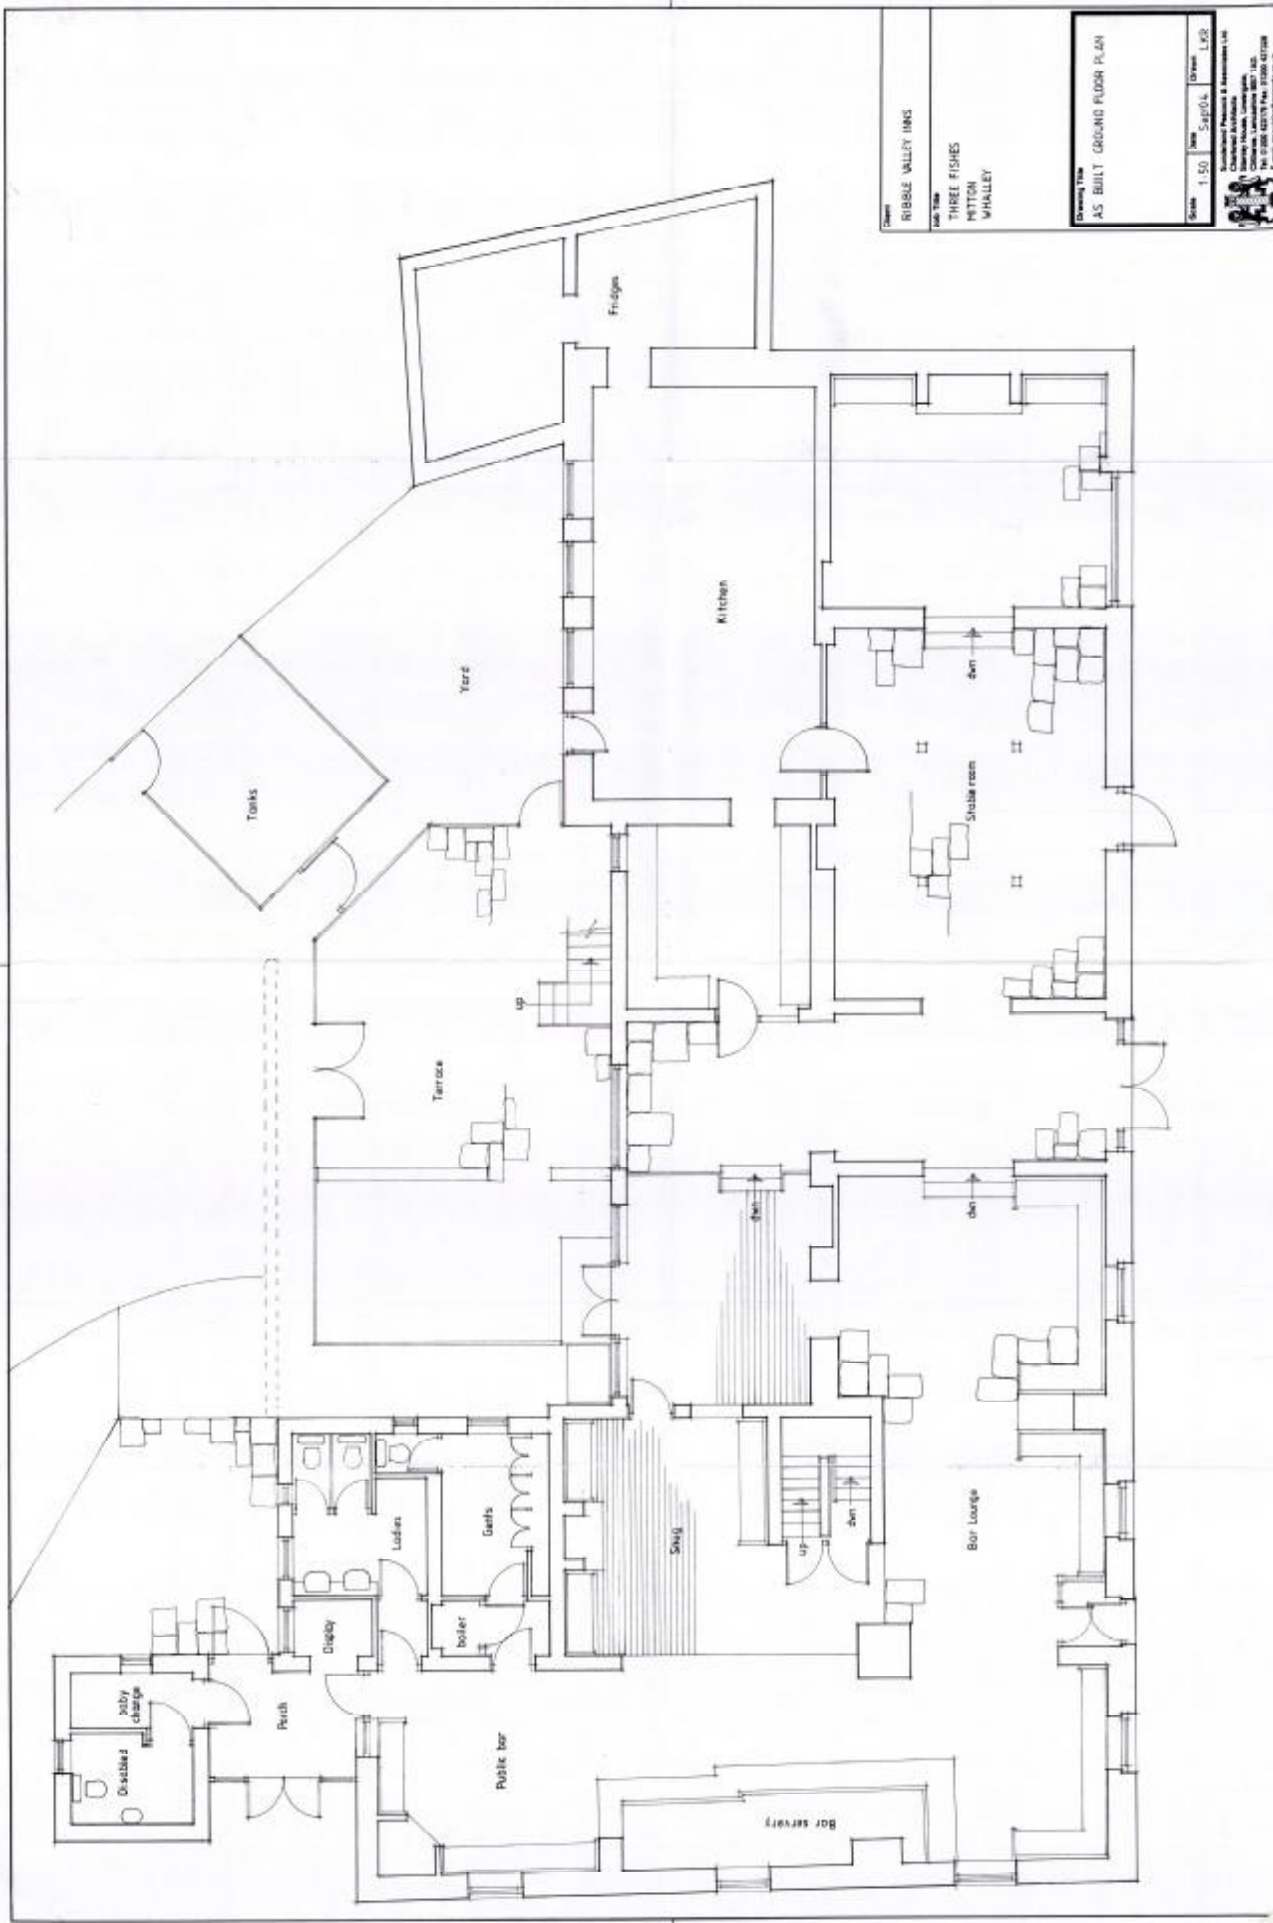

Client: RIBBLE VALLEY INNS


Job Title: THREE FISHES
MITTON
WHALLEY

Drawing Title: AS BUILT GROUND FLOOR PLAN

Scale:	1:50	Area:	3490.0	Drawn:	LKR
--------	------	-------	--------	--------	-----



 SouthWest Projects & Services Ltd.
 100, The Old Mill, Mill Lane,
 Church, Lanchester, MDT 12J.
 Tel: 01927 551177
 Fax: 01927 551178
 Email: info@swprojects.co.uk

3350-17

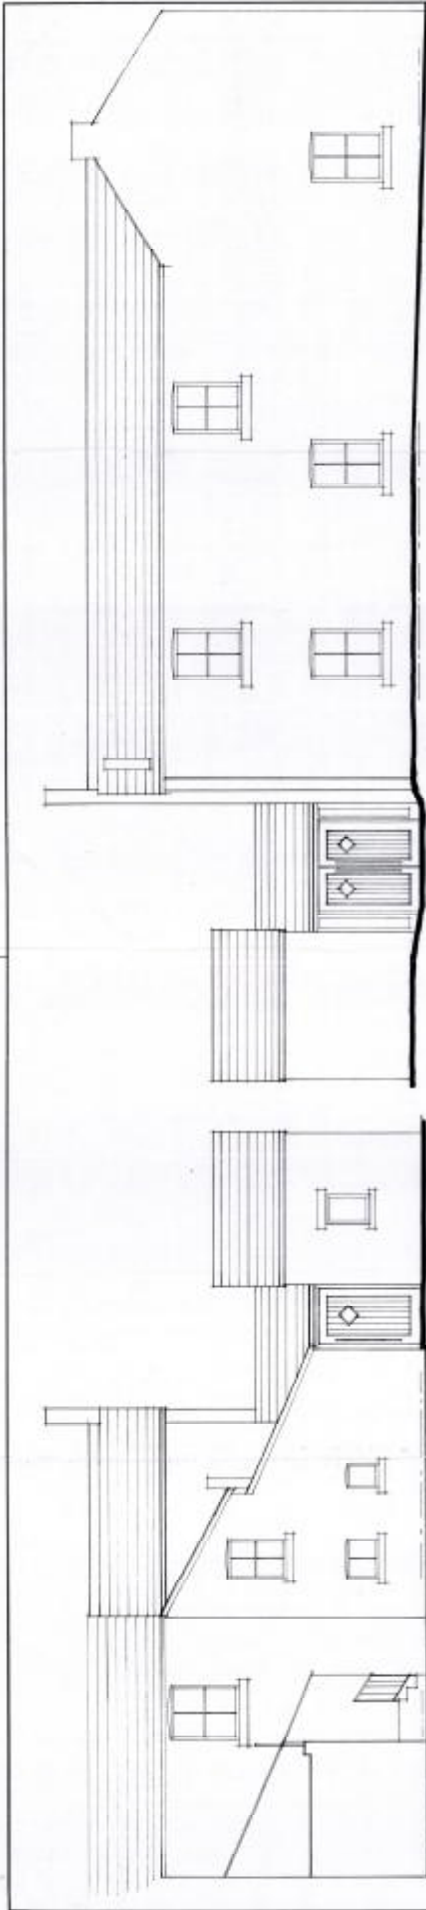


SIDE ELEVATION

ELEVATION A

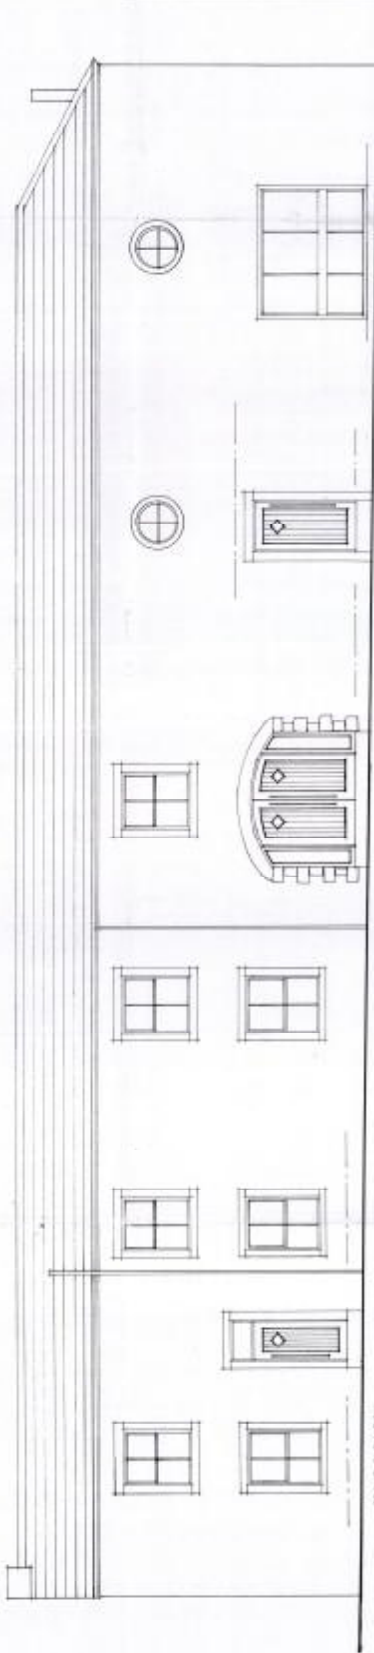

FRONT ELEVATION

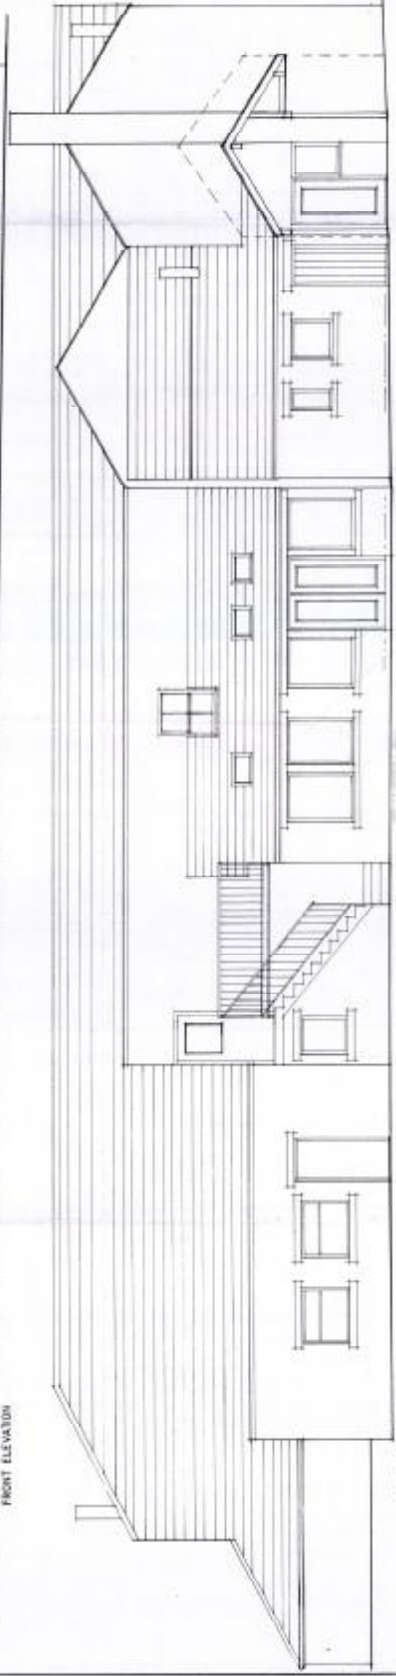

REAR ELEVATION

Client: RIBBLE VALLEY INNS

Job No: THREE FISHES
RITTON
WHALLEY

Scale: 1:50



Drawn: LGR

Checked: LGR

AS BUILT ELEVATIONS

Architectural Practice & Associates
 100, The Old Rectory, Lymm, Cheshire, WA16 0JL
 Tel: 01928 541119 Fax: 01928 541120
 www.architecturalpractice.co.uk

3350 - 12

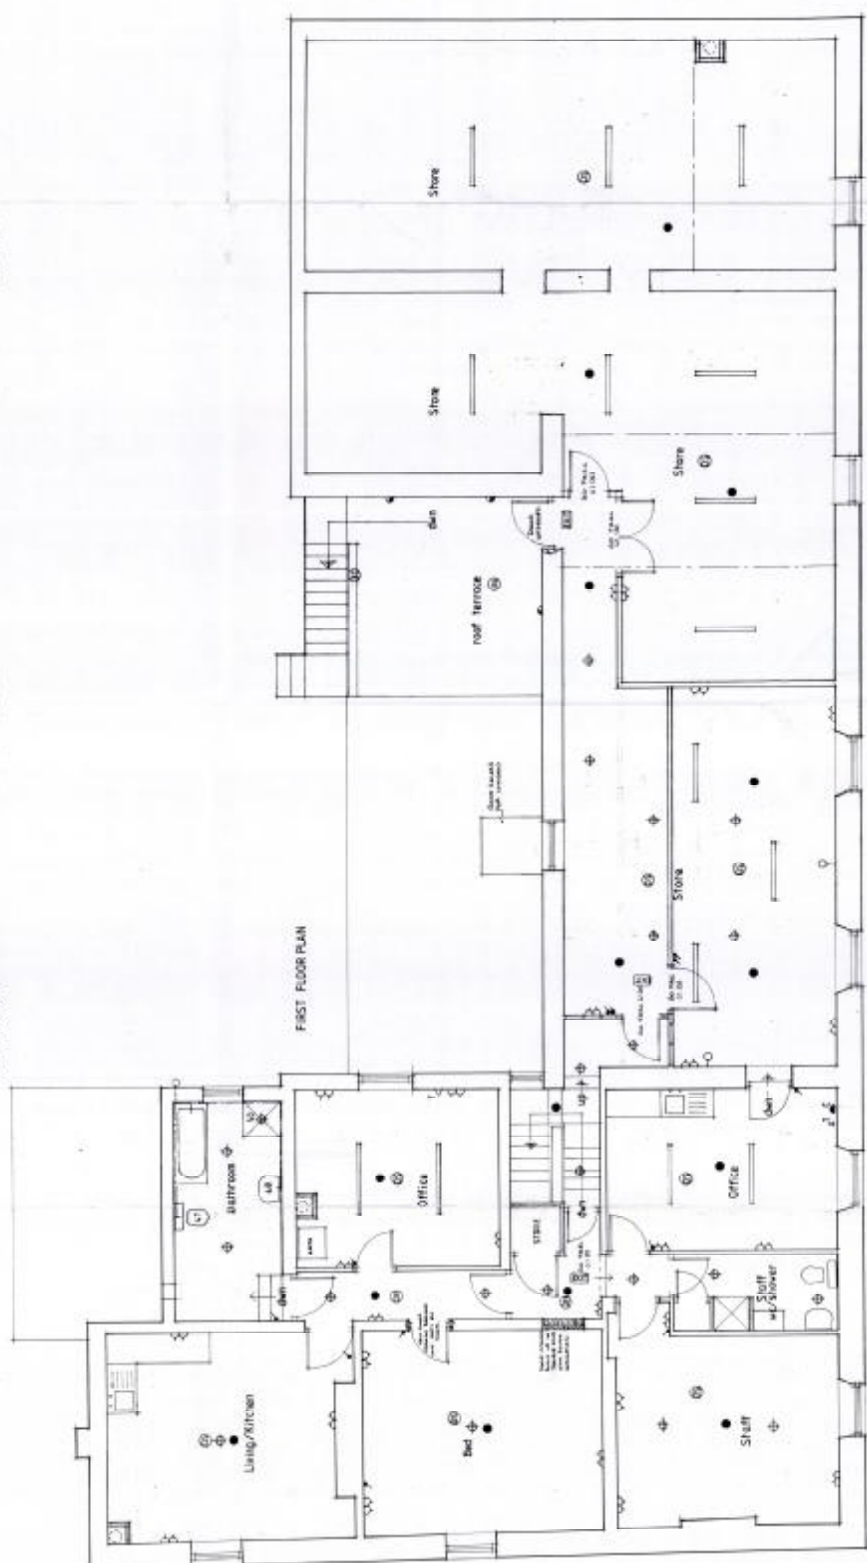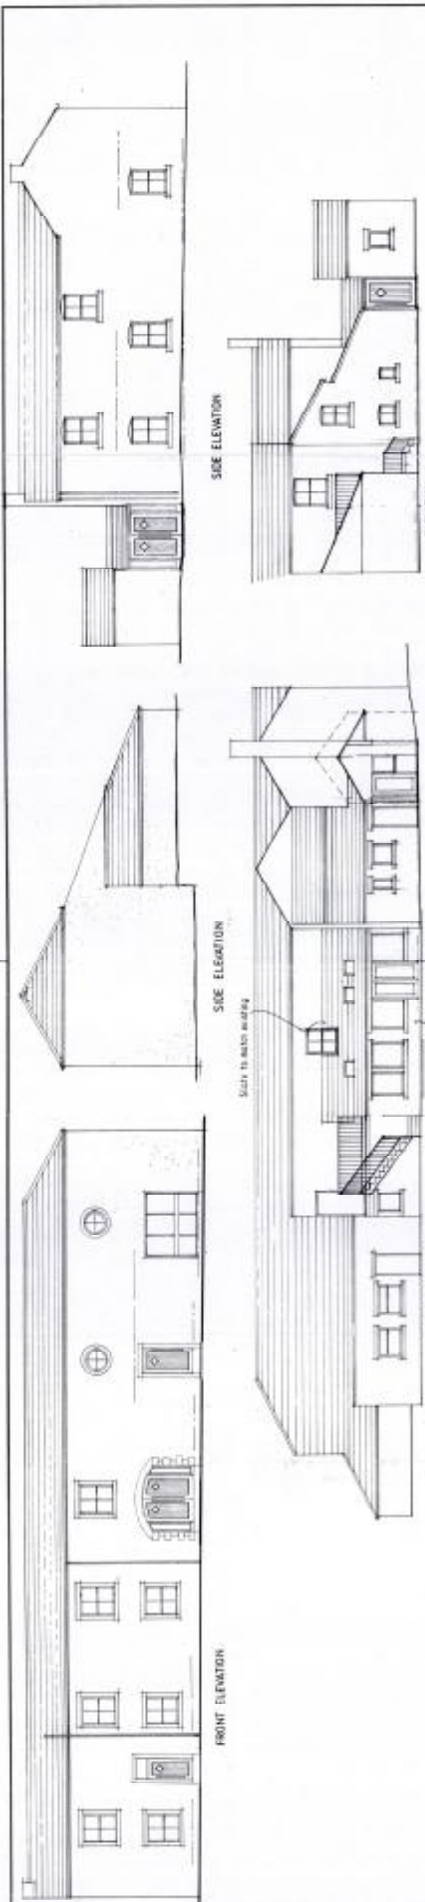

1. - 10/10/10 - 10/10/10
 2. - 10/10/10 - 10/10/10
 3. - 10/10/10 - 10/10/10
 Client: BIRBLE VALLEY TIRMS

Job Title: THREE FISHS MITTON MHALLEY

Drawing Title: AS-BUILT FIRST FLOOR PLANS & ELEVATIONS

Scale: 1:50	Date: MAR 14	Drawn: LOR
Checked: [Signature] Checked: [Signature]		
Drawn: [Signature] Checked: [Signature]		

3350-6