


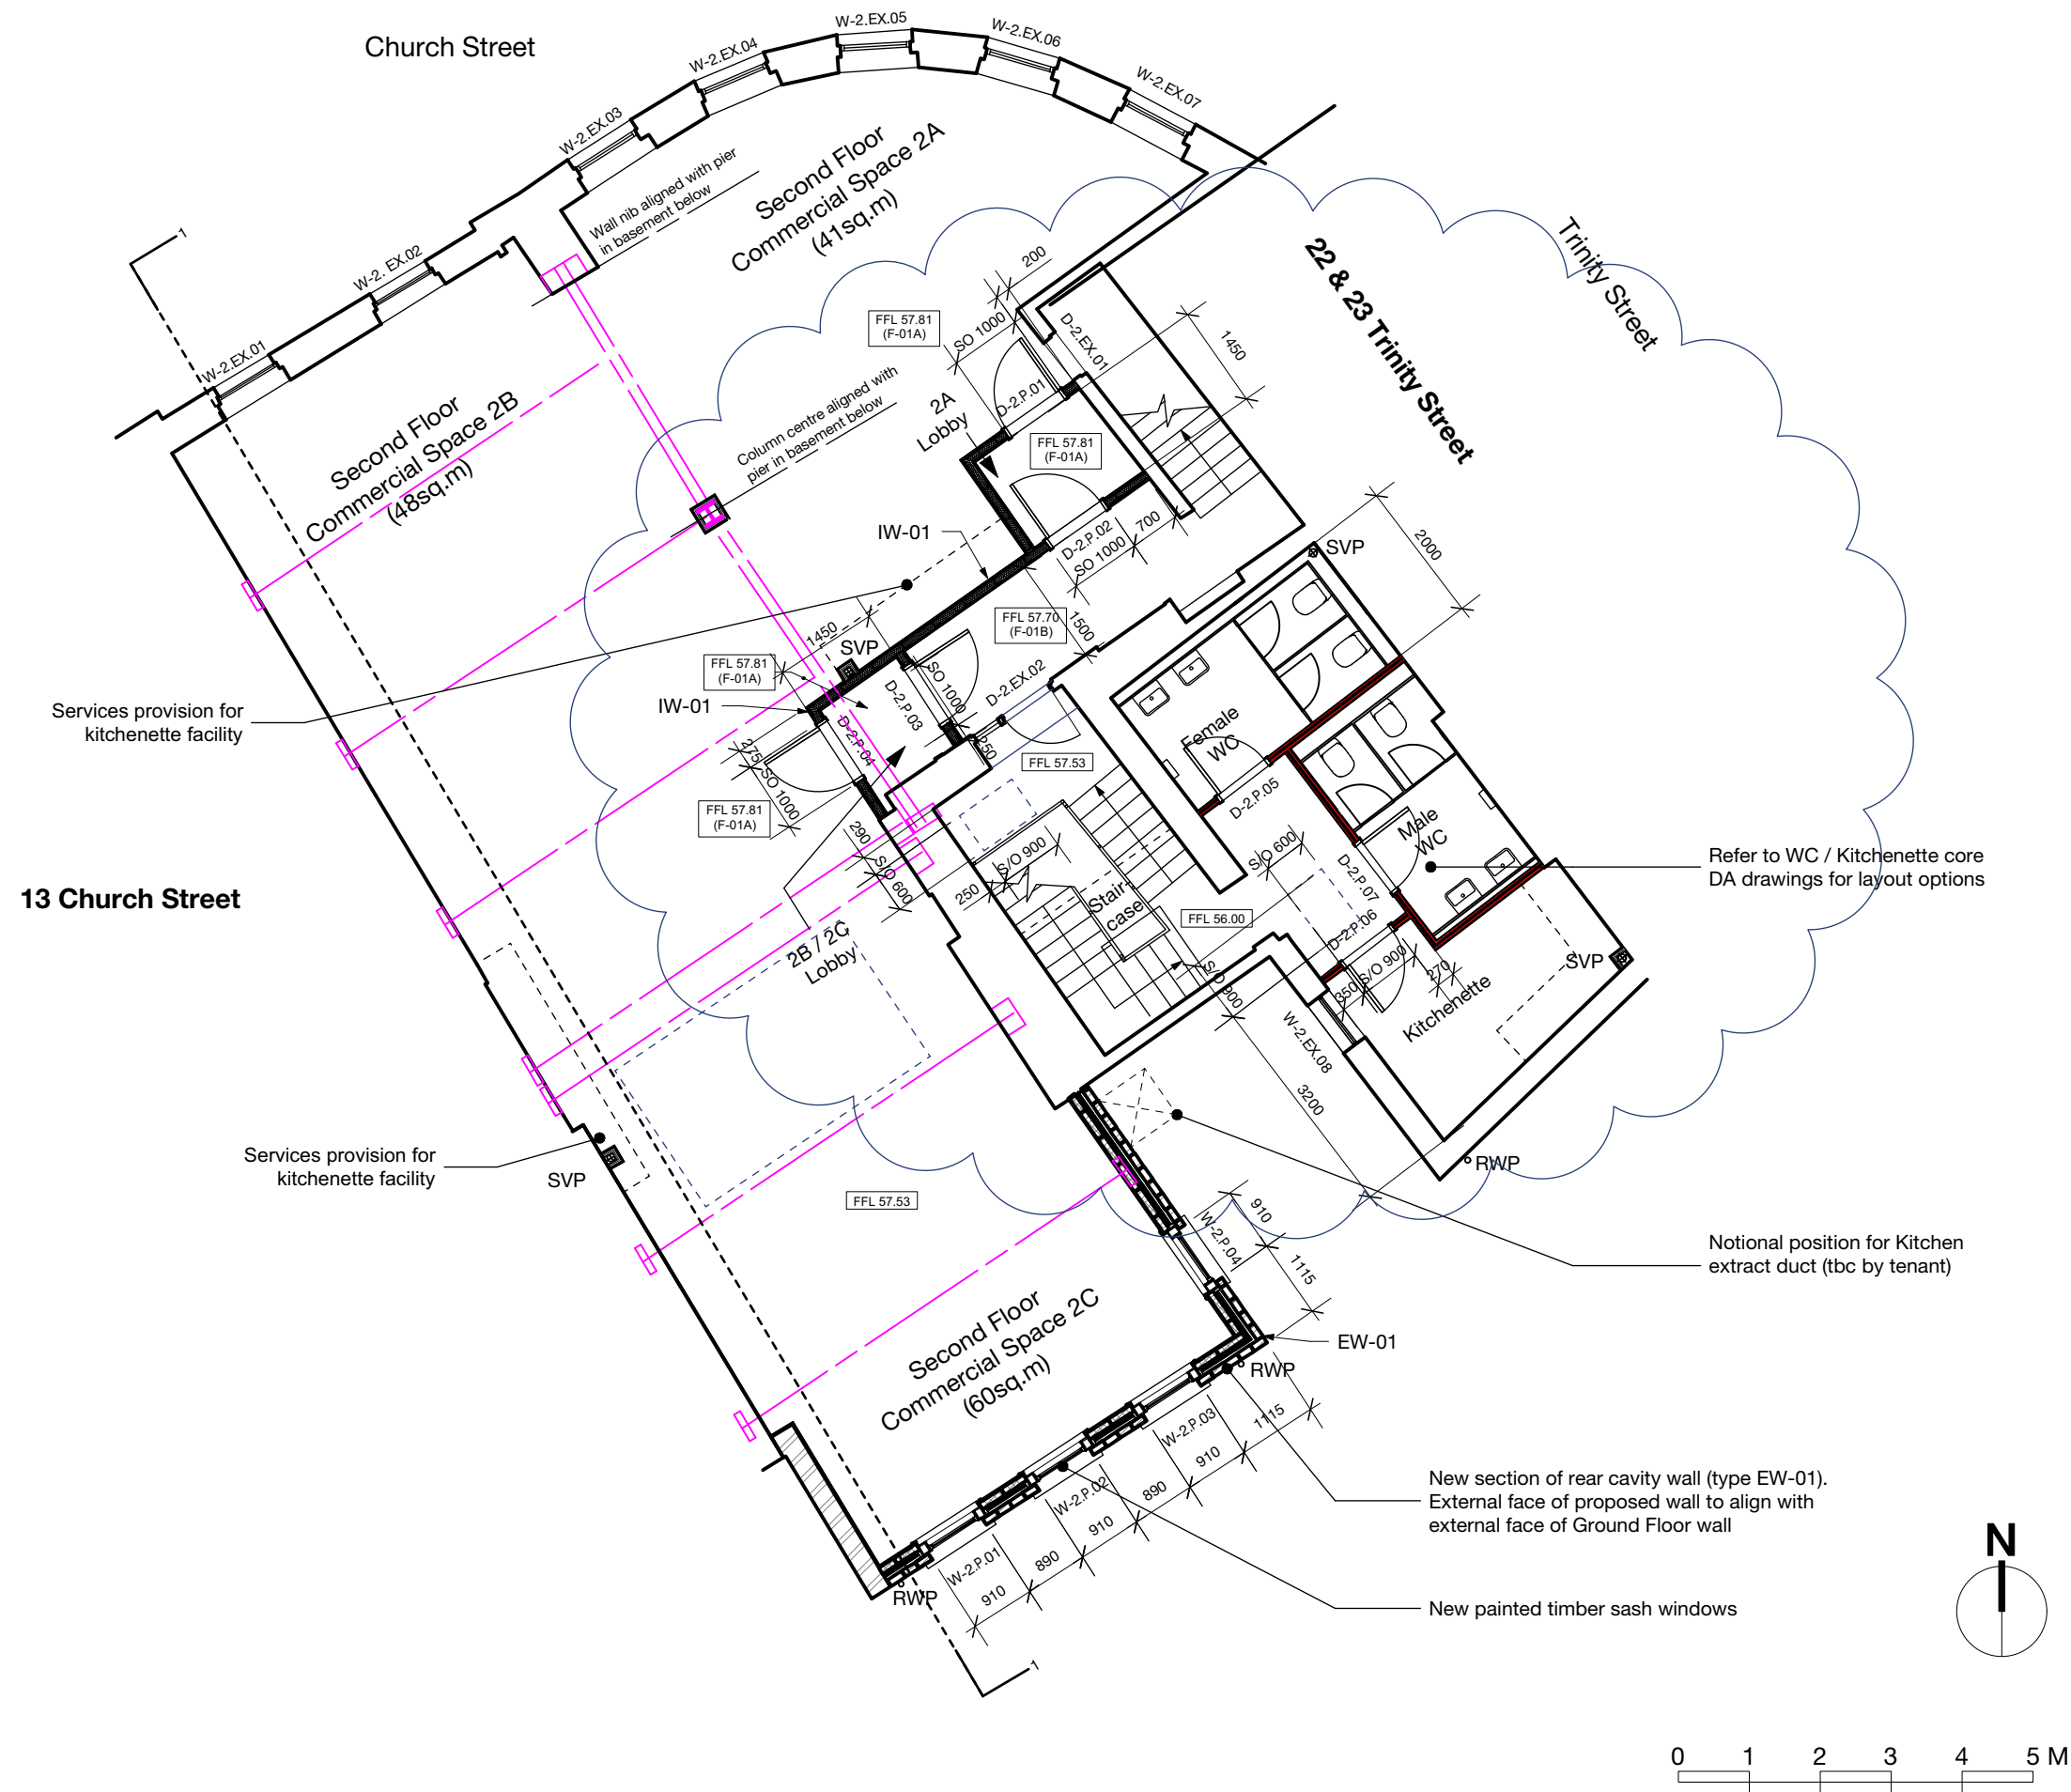

#### GENERAL NOTES

1. This drawing is the copyright of Haines Phillips Architects.
2. Do not scale from this drawing. Use figured dimensions only.
3. This drawing must not be used for land transfer purposes, or for construction purposes unless accompanied by an Architect's Instruction.

#### DRAWING ISSUE STATUS

| ISSUE STATUS            | COMMENT                                                     |
|-------------------------|-------------------------------------------------------------|
| P PRELIMINARY PLANNING  | For comment and review Planning/Listed Building Application |
| BR BUILDING REGS TENDER | Building Regs Application For pricing purposes only         |
| T CONSTRUCTION          | For procurement & construction                              |
| FC FINAL CONSTRUCTION   | Record drawings on completion                               |
| L LEGAL                 | Conveyancing or other legal purposes                        |

#### REVISIONS

| ISSUE | REV | DATE     | NOTES                                                                                                                   |
|-------|-----|----------|-------------------------------------------------------------------------------------------------------------------------|
| T     | 7   | 10/01/22 | RWP indicated to rear elevation. Levels, internal partitions/linings amended. Setting out of roof access hatches added. |
|       | 8   | 08/02/22 | Roof access hatches amended                                                                                             |
|       | 9   | 16/02/22 | Floor levels/types and WC/Kitchenette core amended                                                                      |

**HAINES PHILLIPS**  
ARCHITECTS

**Tankerton Works**  
12 Argyle Walk  
London WC1H 8HA  
t 020 7833 9324  
f 020 7837 2864  
e office@hainesphillips.co.uk

#### JOB TITLE

**11 & 12 Church Street  
Cardiff CF10 1BG**

#### DRAWING TITLE

**Second Floor Plan  
As Proposed**

#### DRAWN

HT

JOB NR

**4159**

DRAWING NO.

**GA 313**

#### DATE

April 2020

SCALE

**1:100@A3**

ISSUE REVISION

**T 9**