




BASEMENT

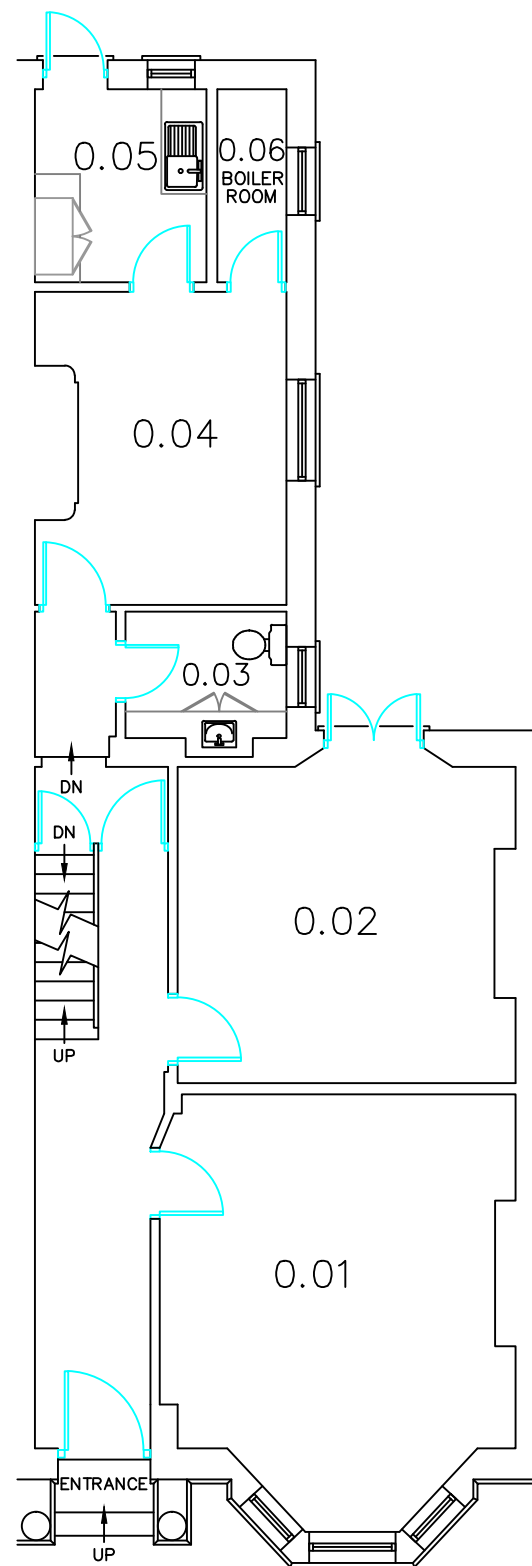


GROUND FLOOR

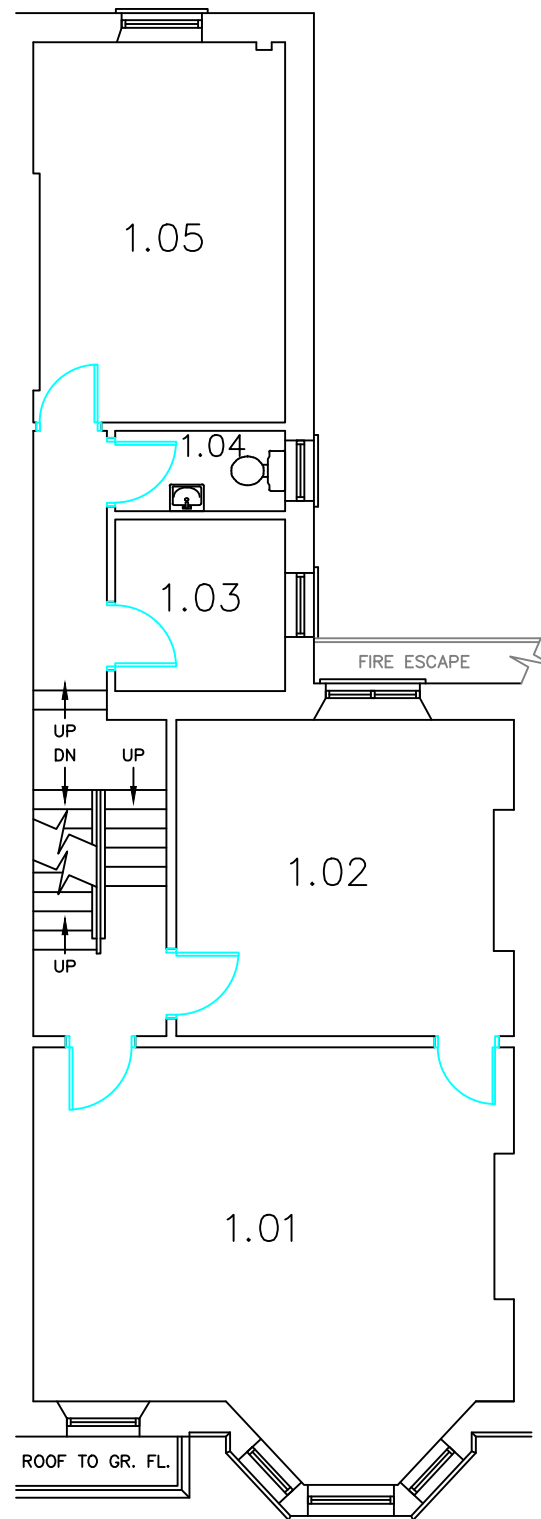

FIRST FLOOR

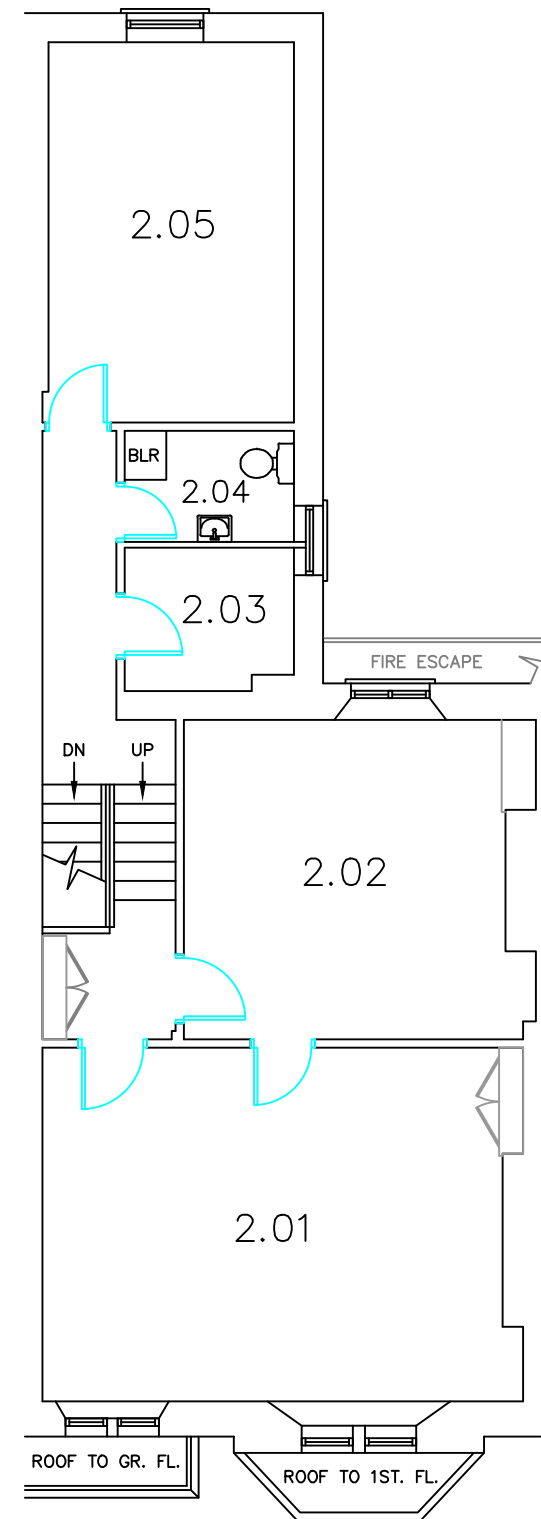

SECOND FLOOR

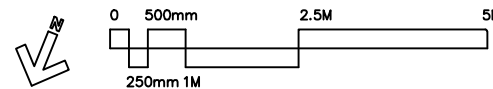

ESTATES DIVISION



TITLE
**No. 6 MUSEUM PLACE.
 PLAN OF ALL FLOORS.**

SCALE 1:100\A3 SHEET ORIGINAL LAYOUT DRAW GPI

LAST REVISED: JAS - 03/09/2009
 DRAWN/DATE

REC. DWG. No. **AO\A031\FP\1_02**

RECORD DRAWING