
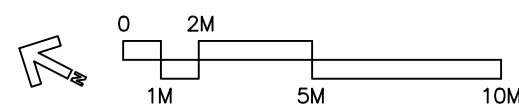


GROUND FLOOR

Estates	
Title McKENZIE HOUSE. BASEMENT AND GROUND FLOOR PLAN.	
Scale: 1:200 A3 SHEET	Original Layout Drawn: GPI
Last Revised Drawn/Date:	AI - 08/08/2019
Rec. Drg. No.:	AN\AN10\FP\1_00
Record Drawing	

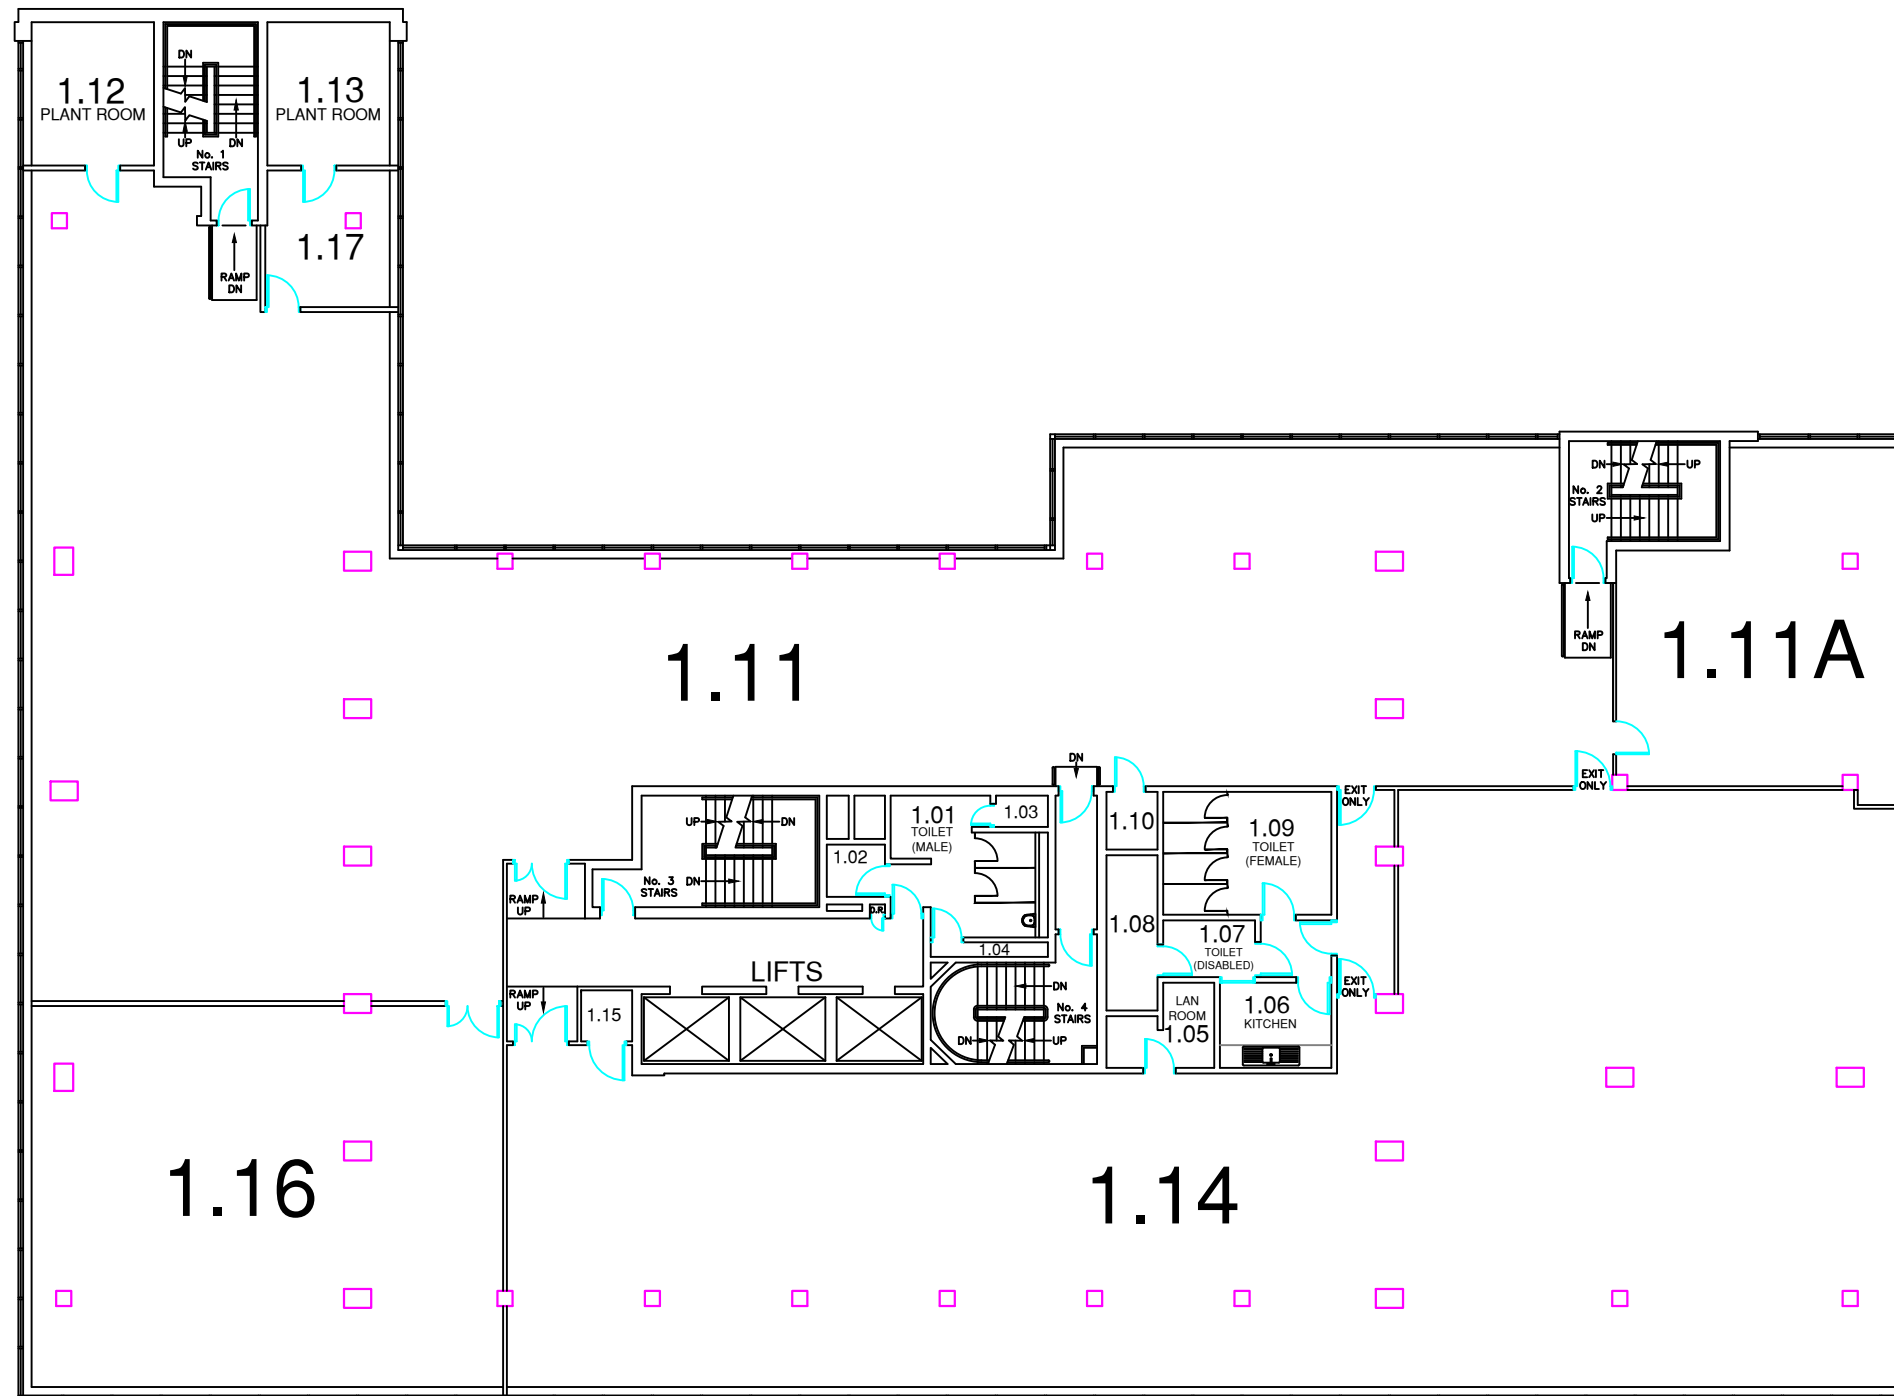

Estates



Title
**McKENZIE HOUSE.
 FIRST FLOOR PLAN.**

Scale: 1:200 \A3 SHEET Original Layout Drawn: GPI

Last Revised Drawn/Date: AI - 08/08/2019

Rec. Drg. No.: AN\AN10\FP\01

Record Drawing

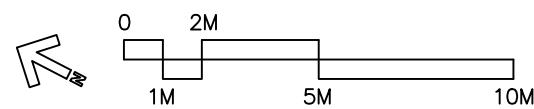
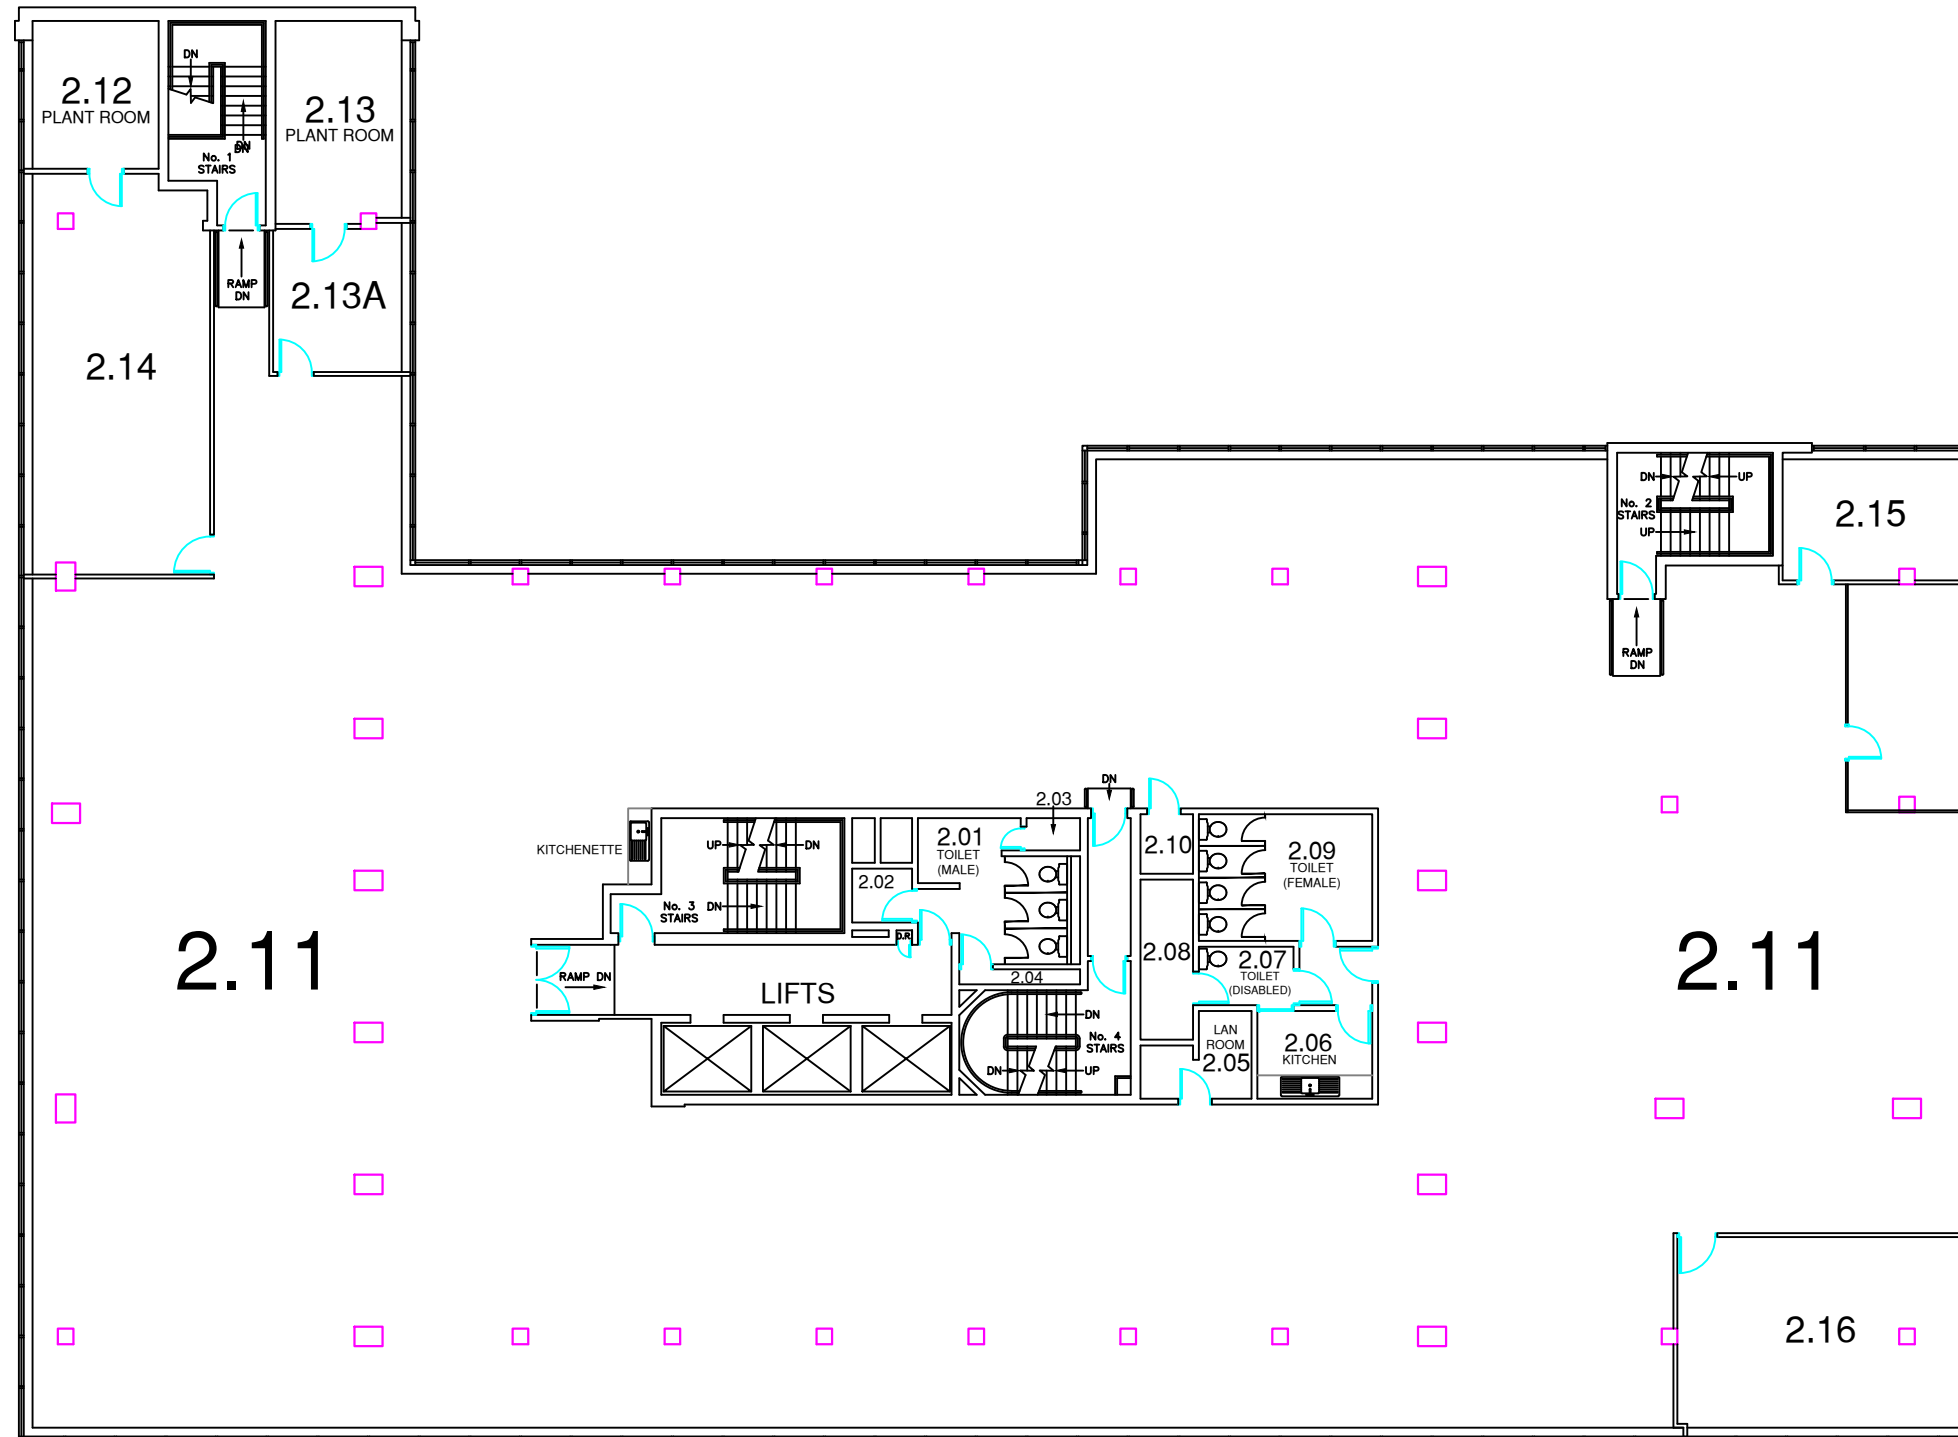


Estates

Title
**McKENZIE HOUSE.
 SECOND FLOOR PLAN.**

Scale: 1:200\A3 SHEET	Original Layout Drawn: GPI
Last Revised Drawn/Date:	AI - 08/08/2019
Rec. Drg. No.:	AN\AN10\FP\02

Record Drawing

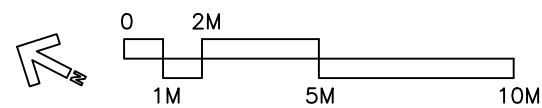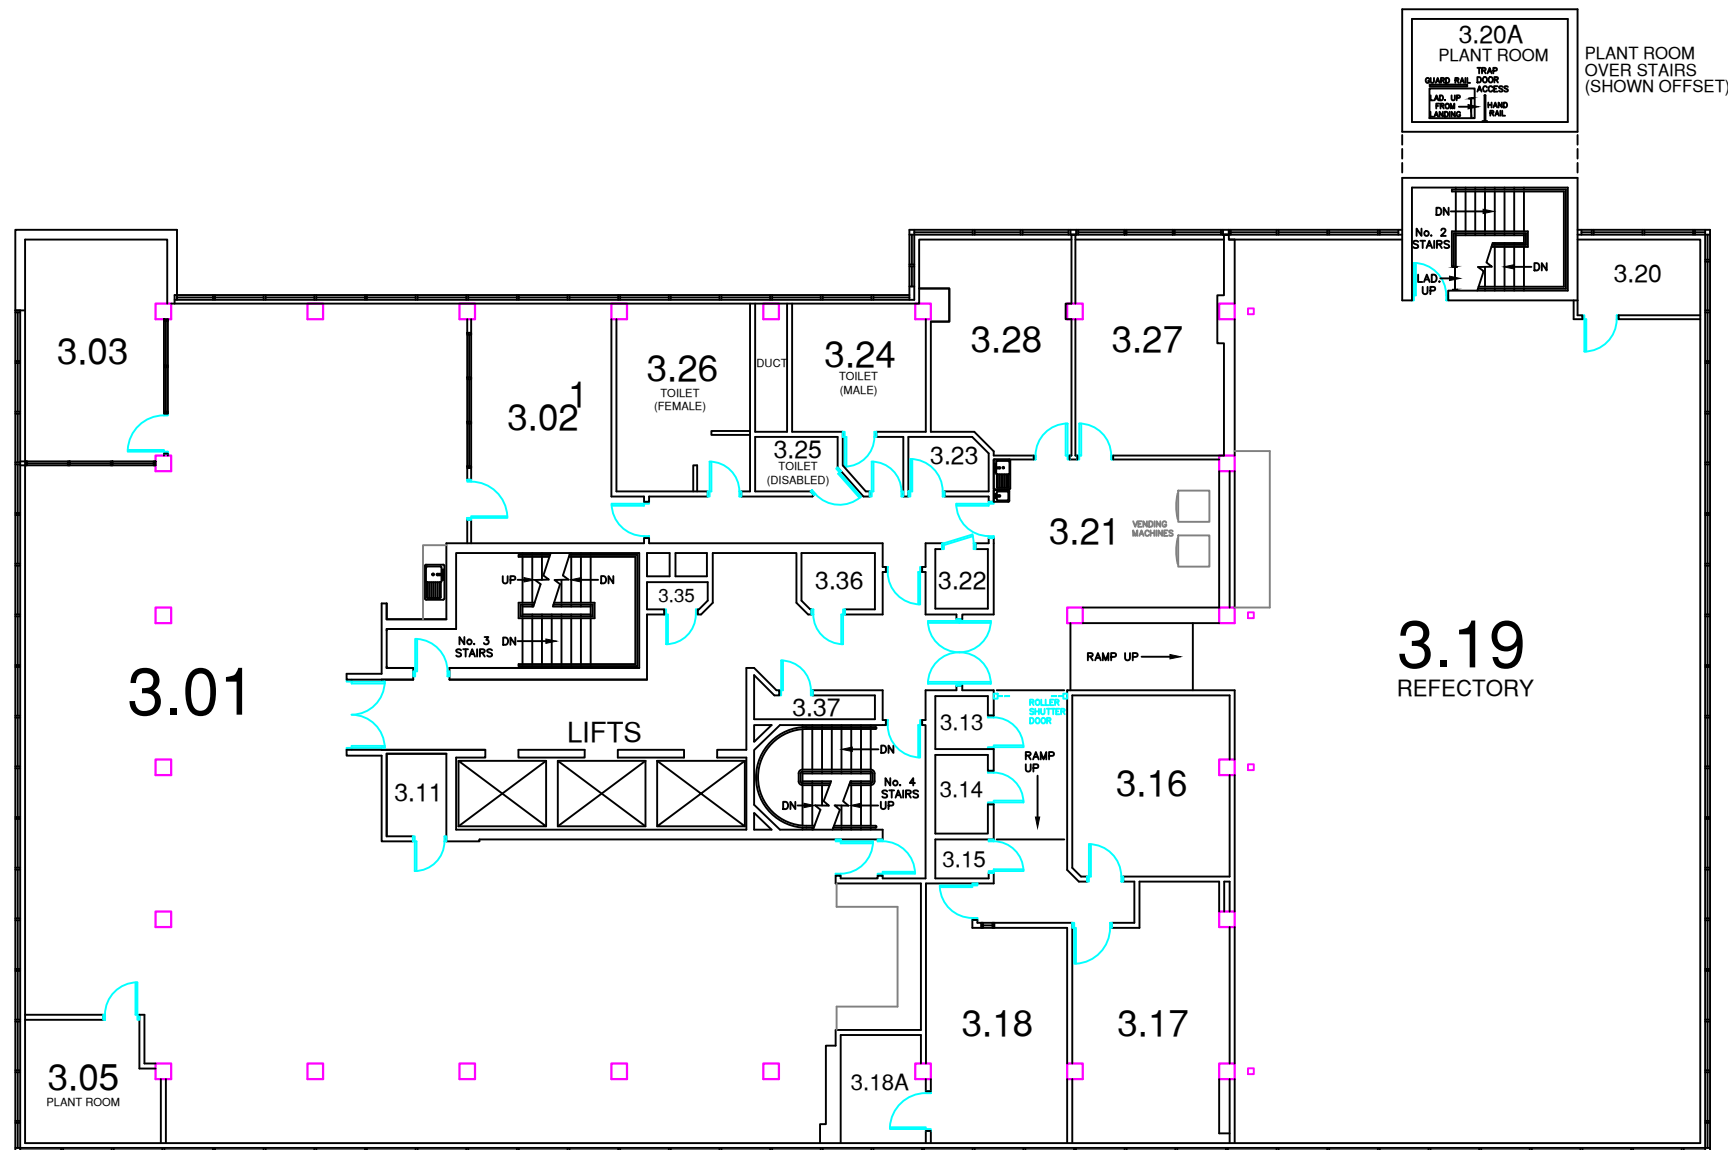



Estates

Title
**McKENZIE HOUSE.
 THIRD FLOOR PLAN.**

Scale: 1:200 \A3 SHEET	Original Layout Drawn: GPI
Last Revised Drawn/Date:	RLF - 15/01/2020
Rec. Drg. No.:	AN \AN10 \FP \03

Record Drawing

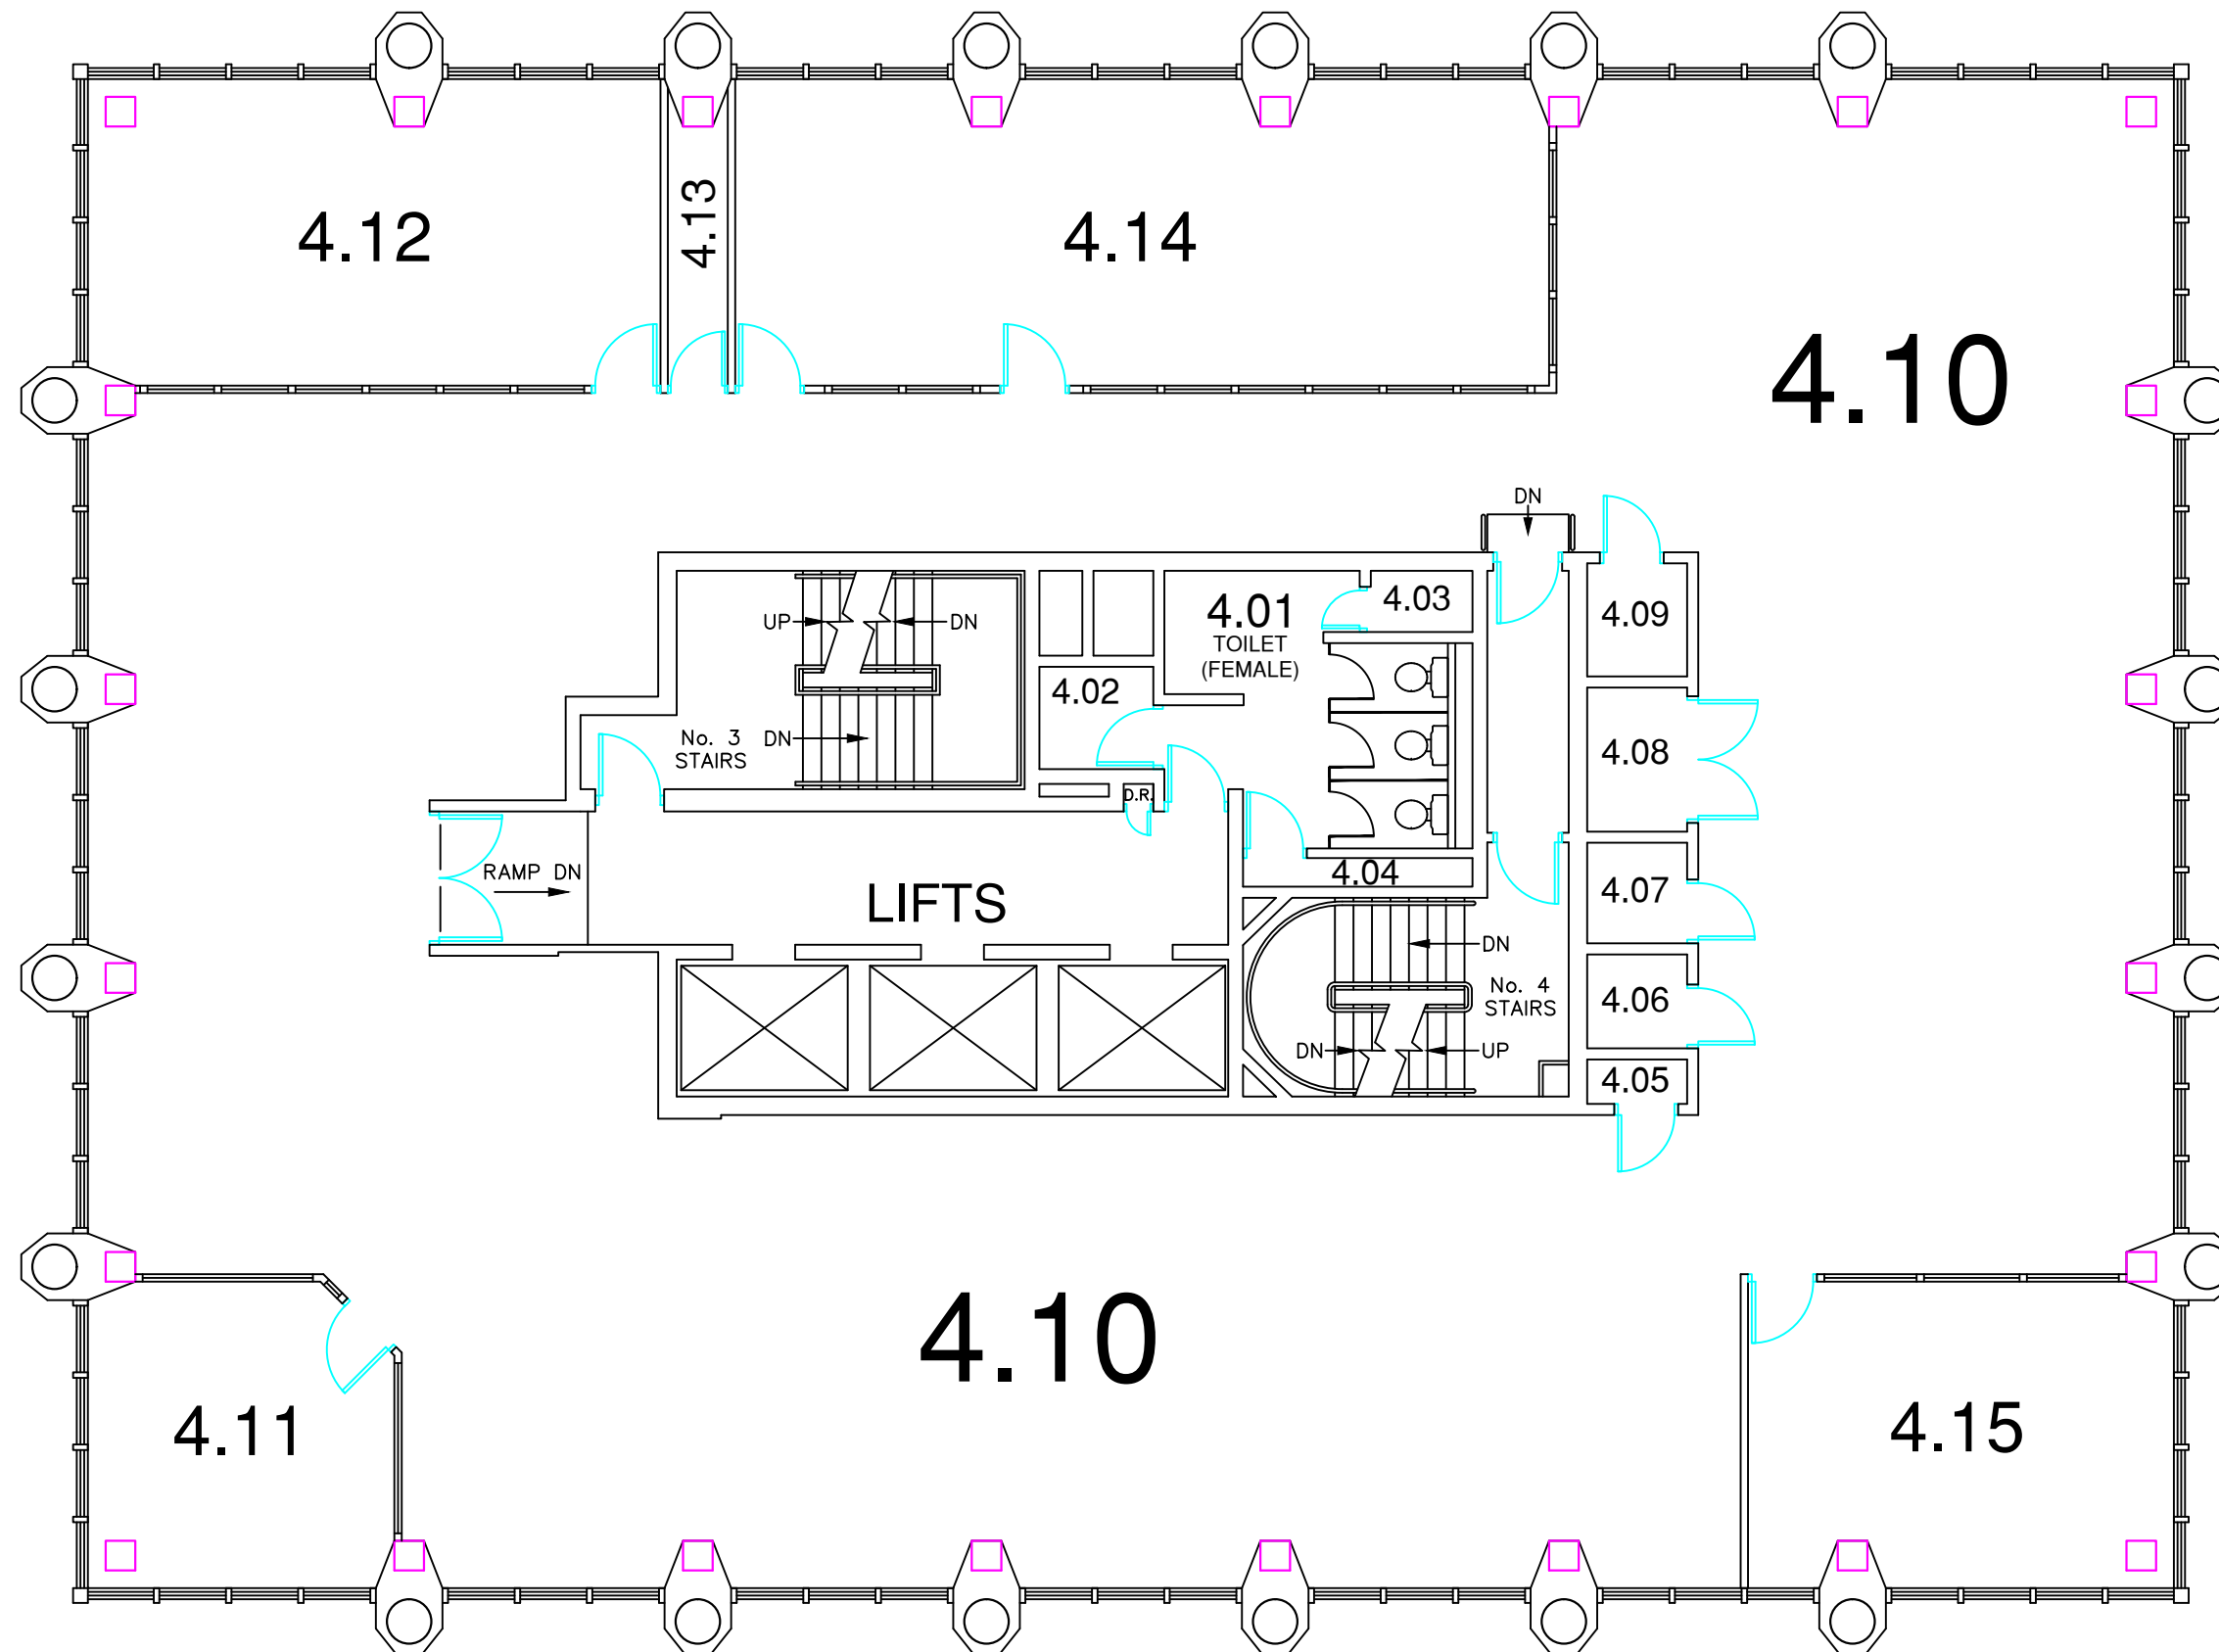

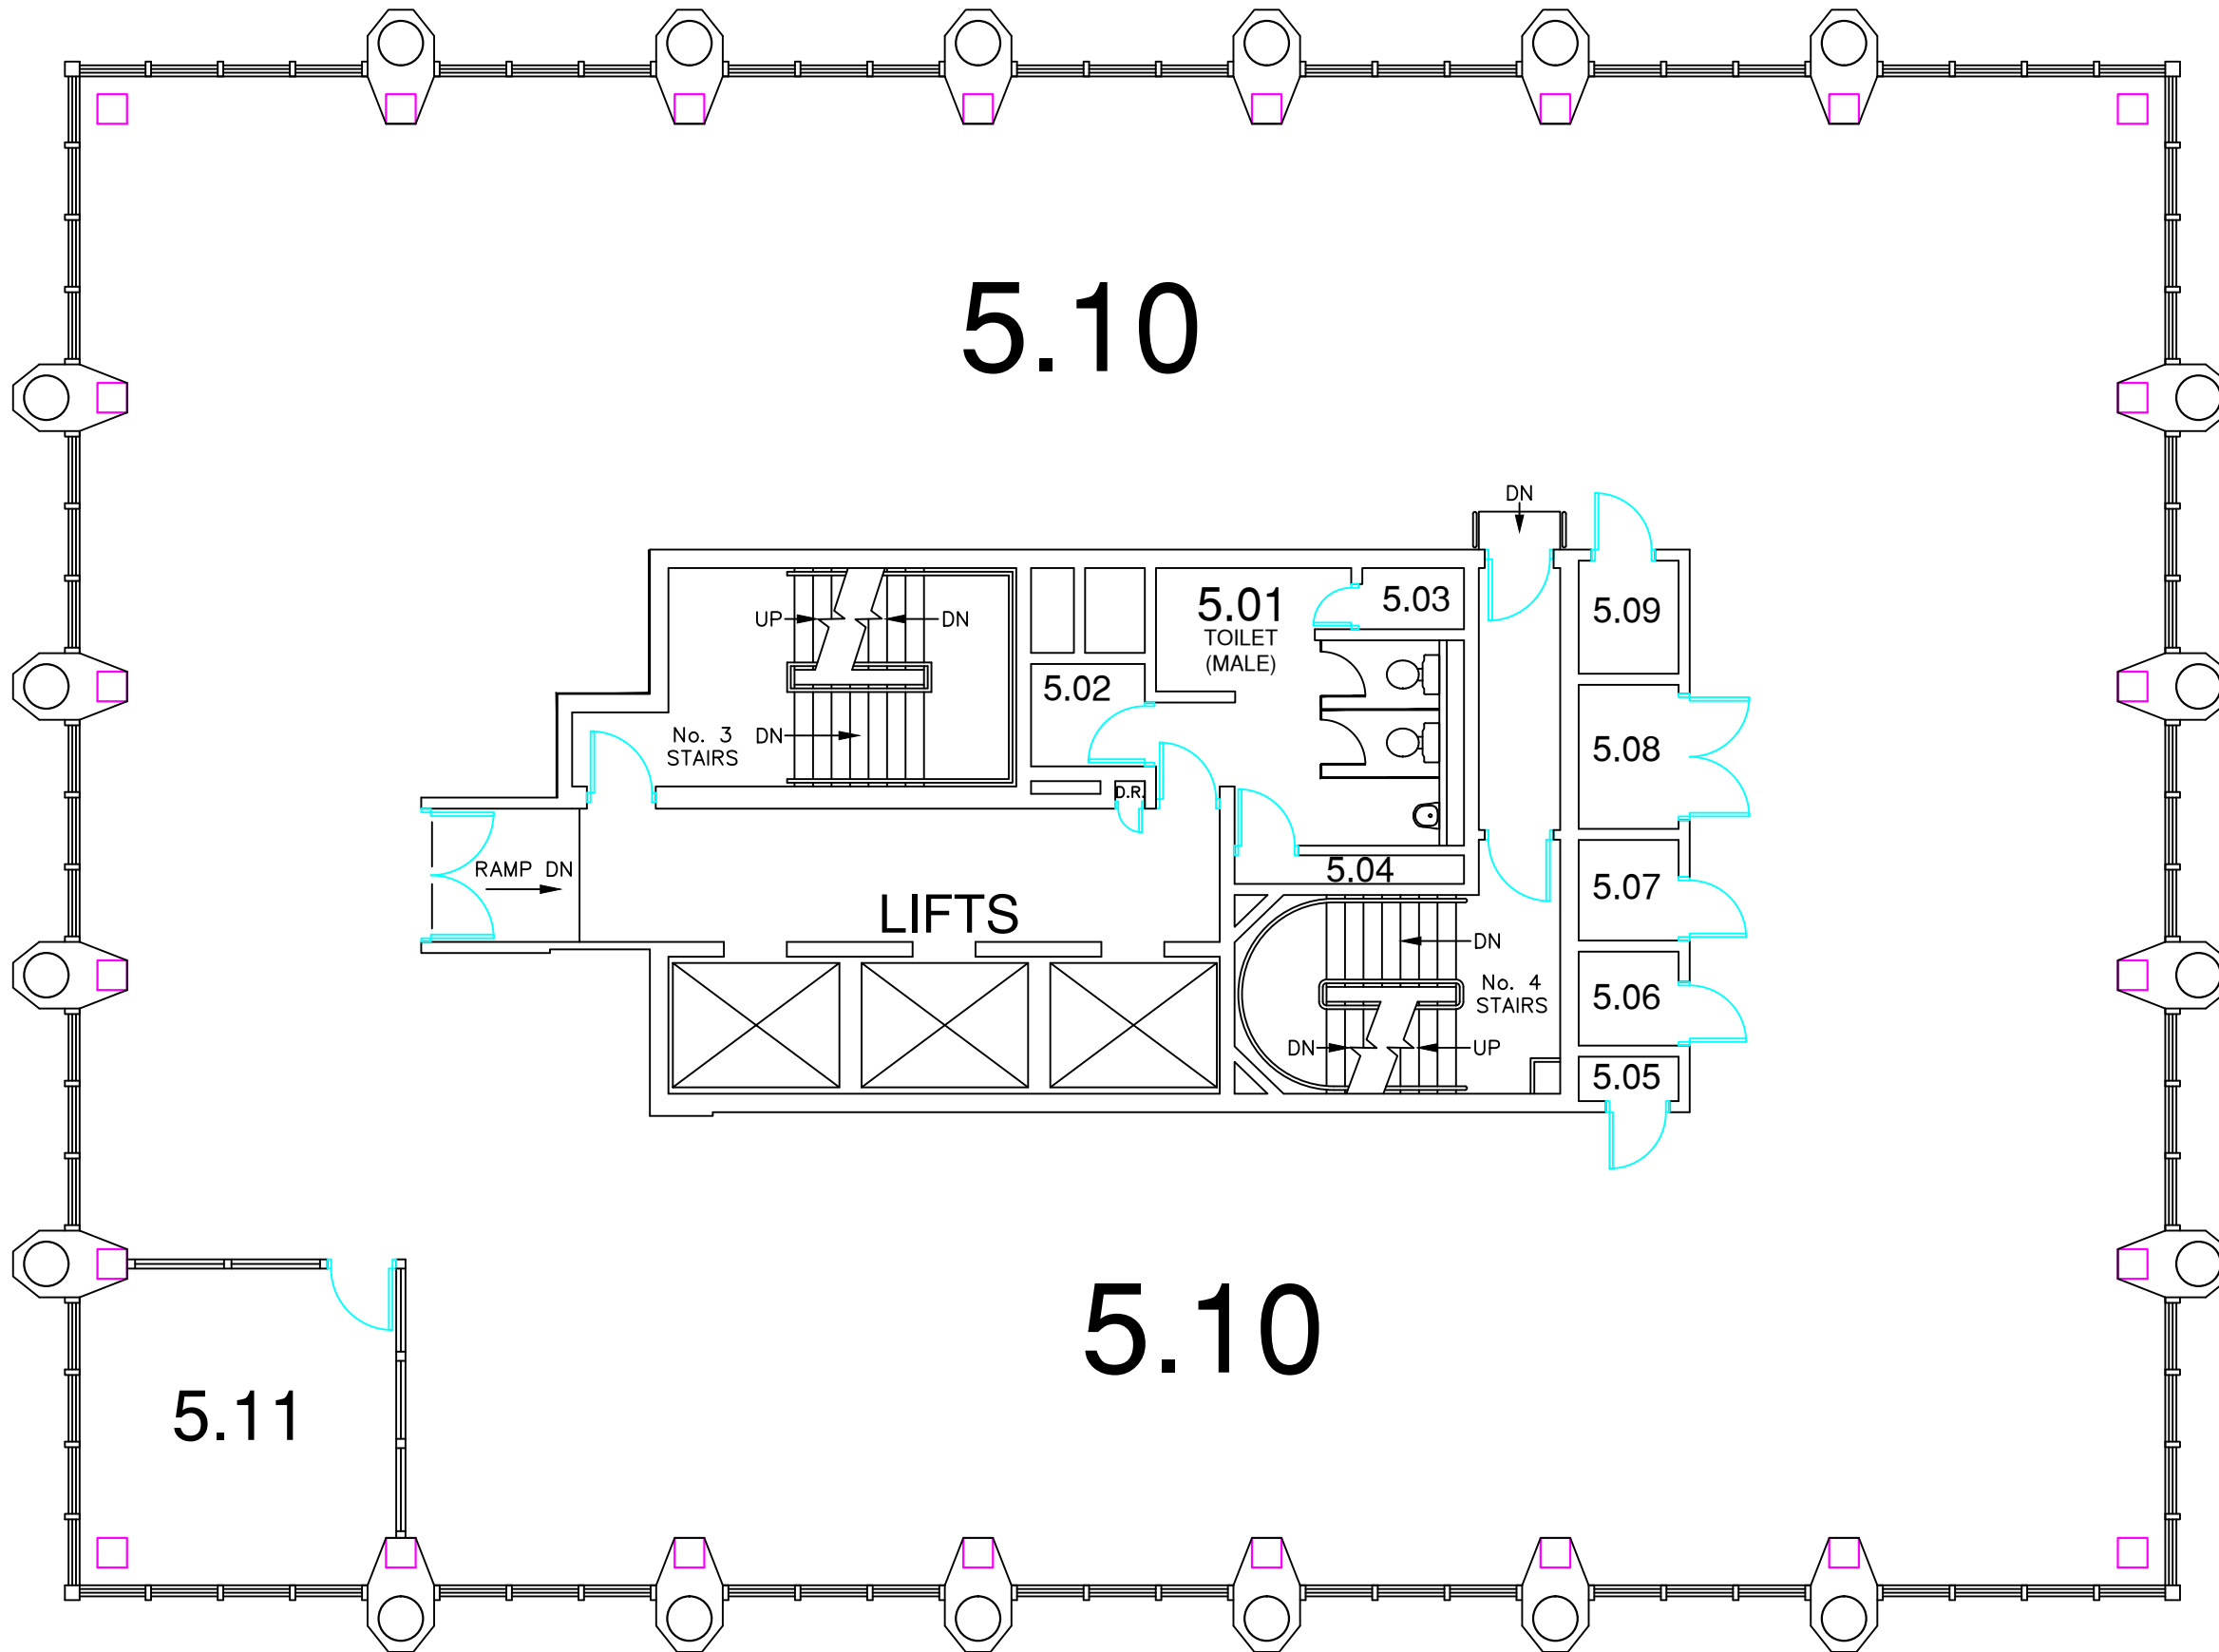


Estates

Title
**McKENZIE HOUSE.
 FIFTH FLOOR PLAN.**

Scale: 1:100\A3 SHEET	Original Layout Drawn: GPI
Last Revised Drawn/Date:	RLF - 15/09/2020
Rec. Drg. No.:	AN\AN10\FP\05

Record Drawing

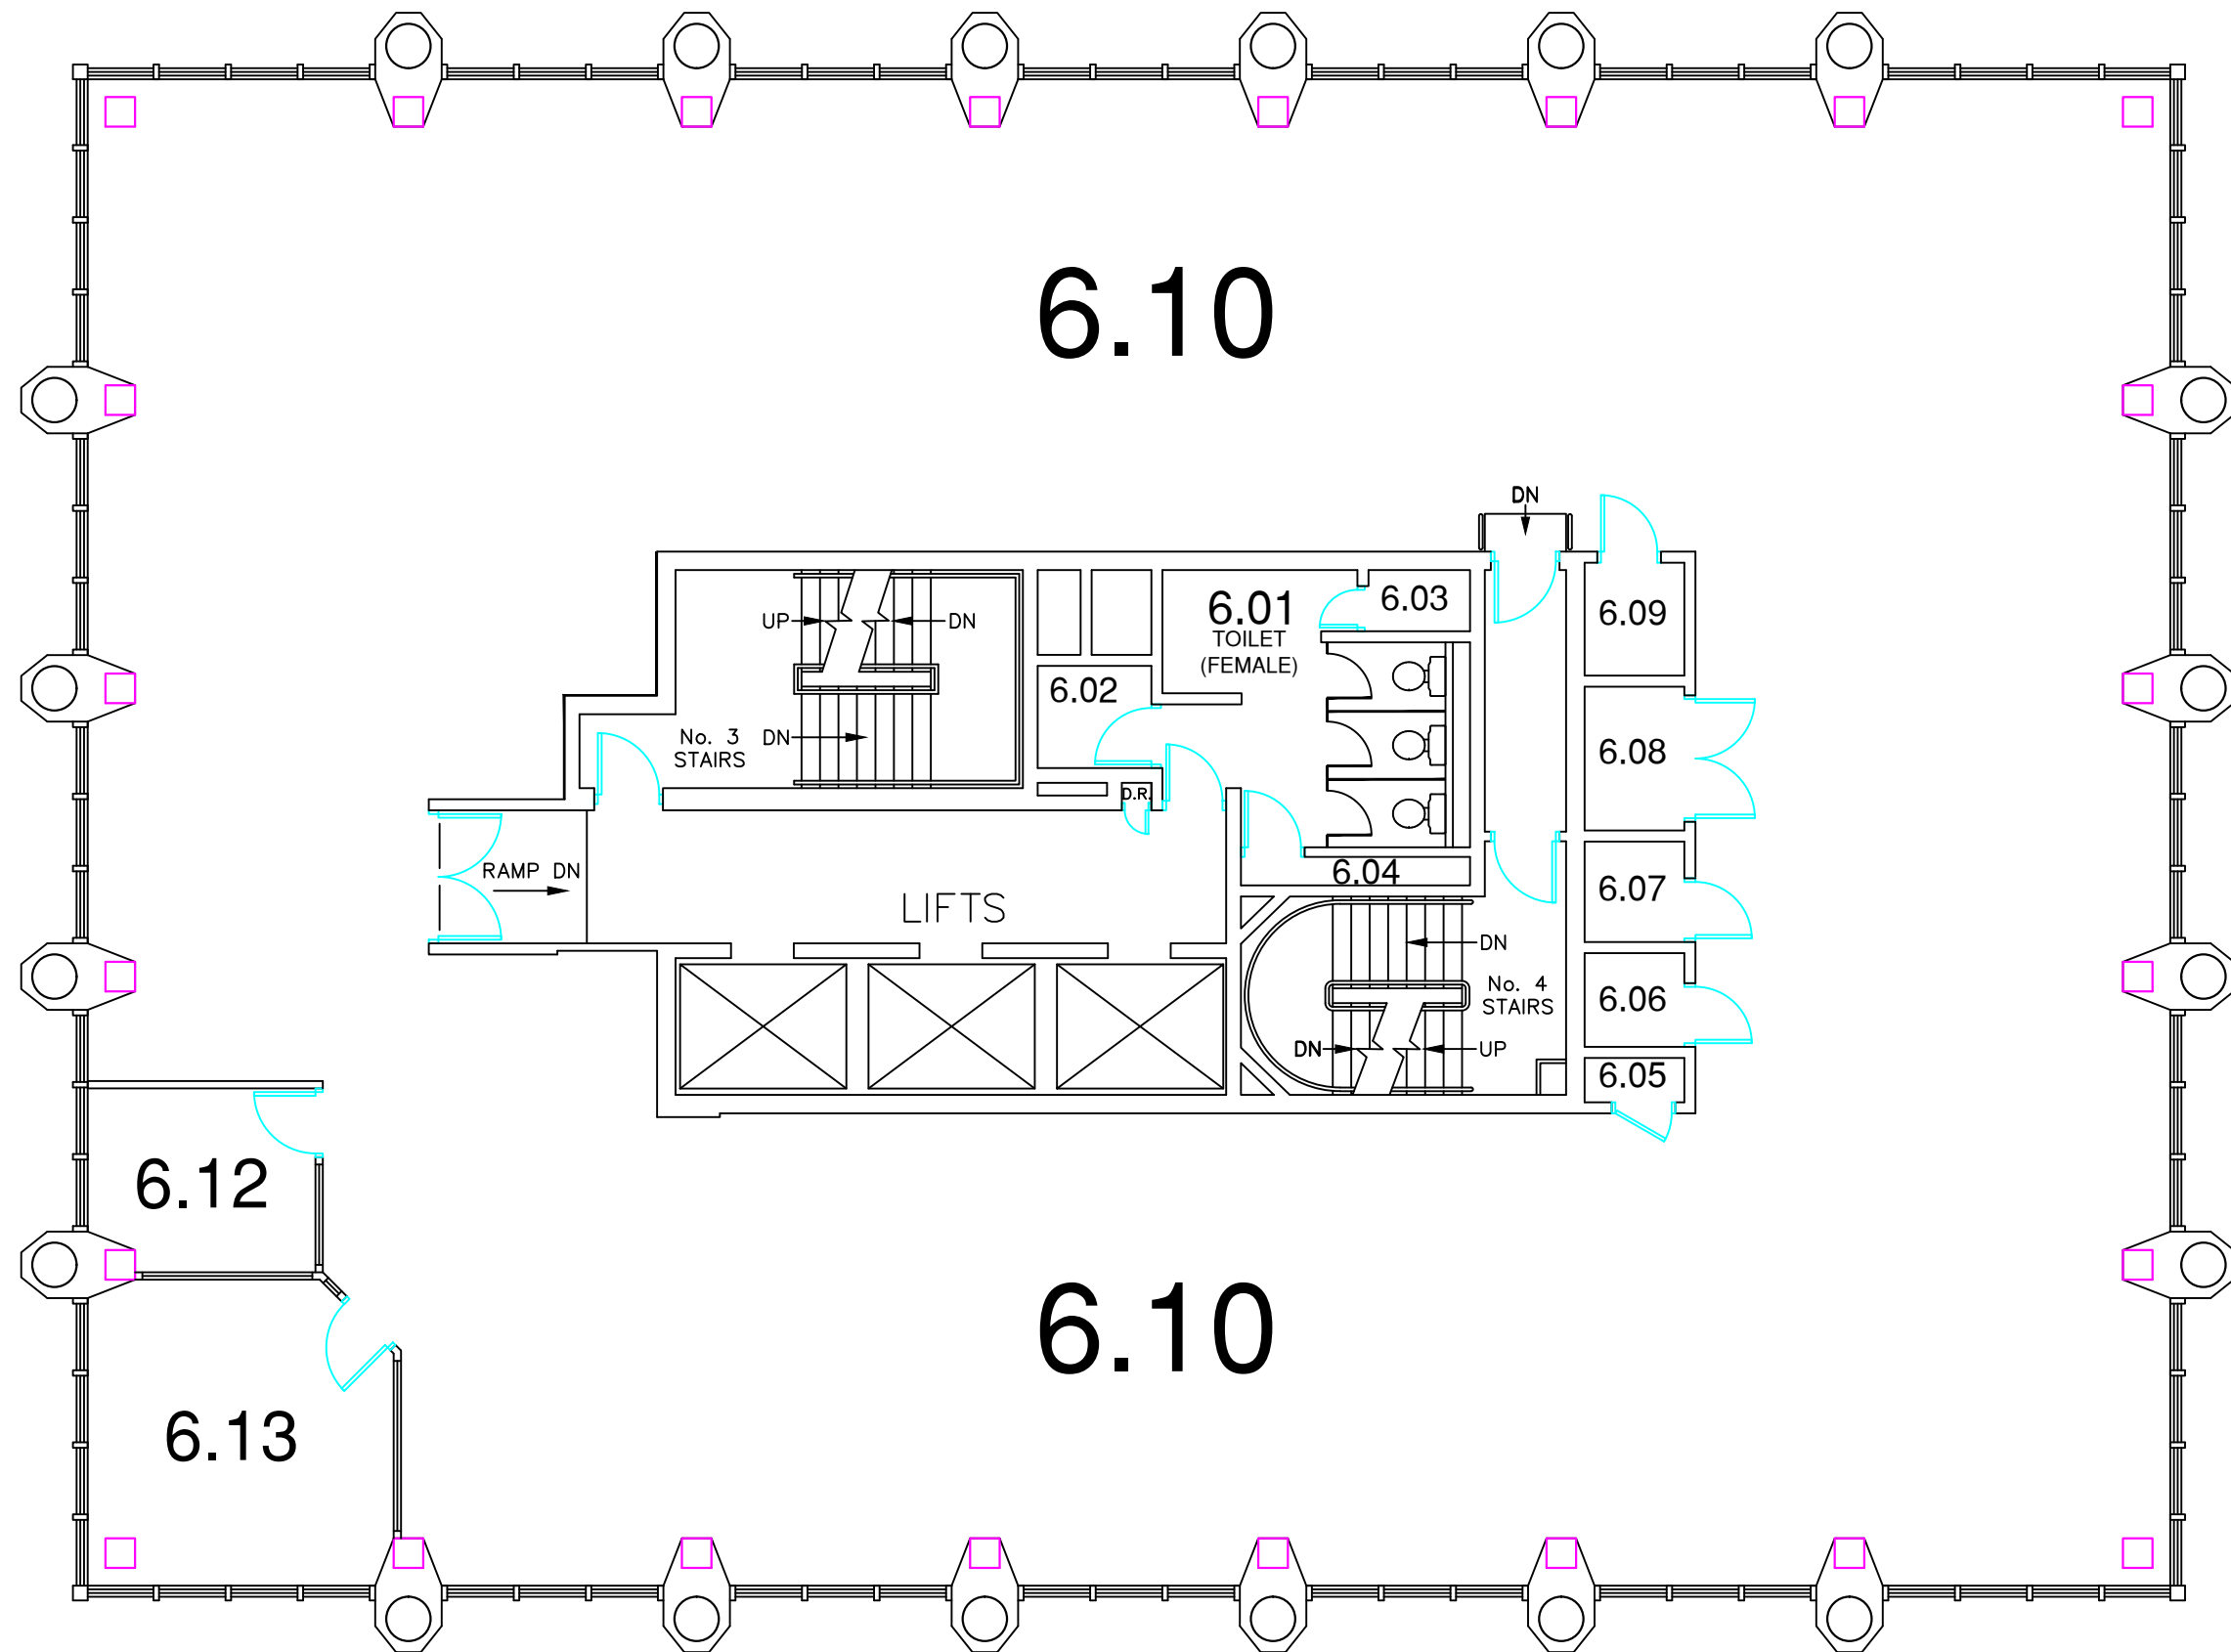

Estates

Title
**McKENZIE HOUSE.
SIXTH FLOOR PLAN.**


Scale:
1:100\A3 SHEET

Original Layout Drawn:
GPI

Last Revised
Drawn/Date: **RLF - 15/09/2020**

Rec. Drg. No.: **AN\AN10\FP\06**

Record Drawing

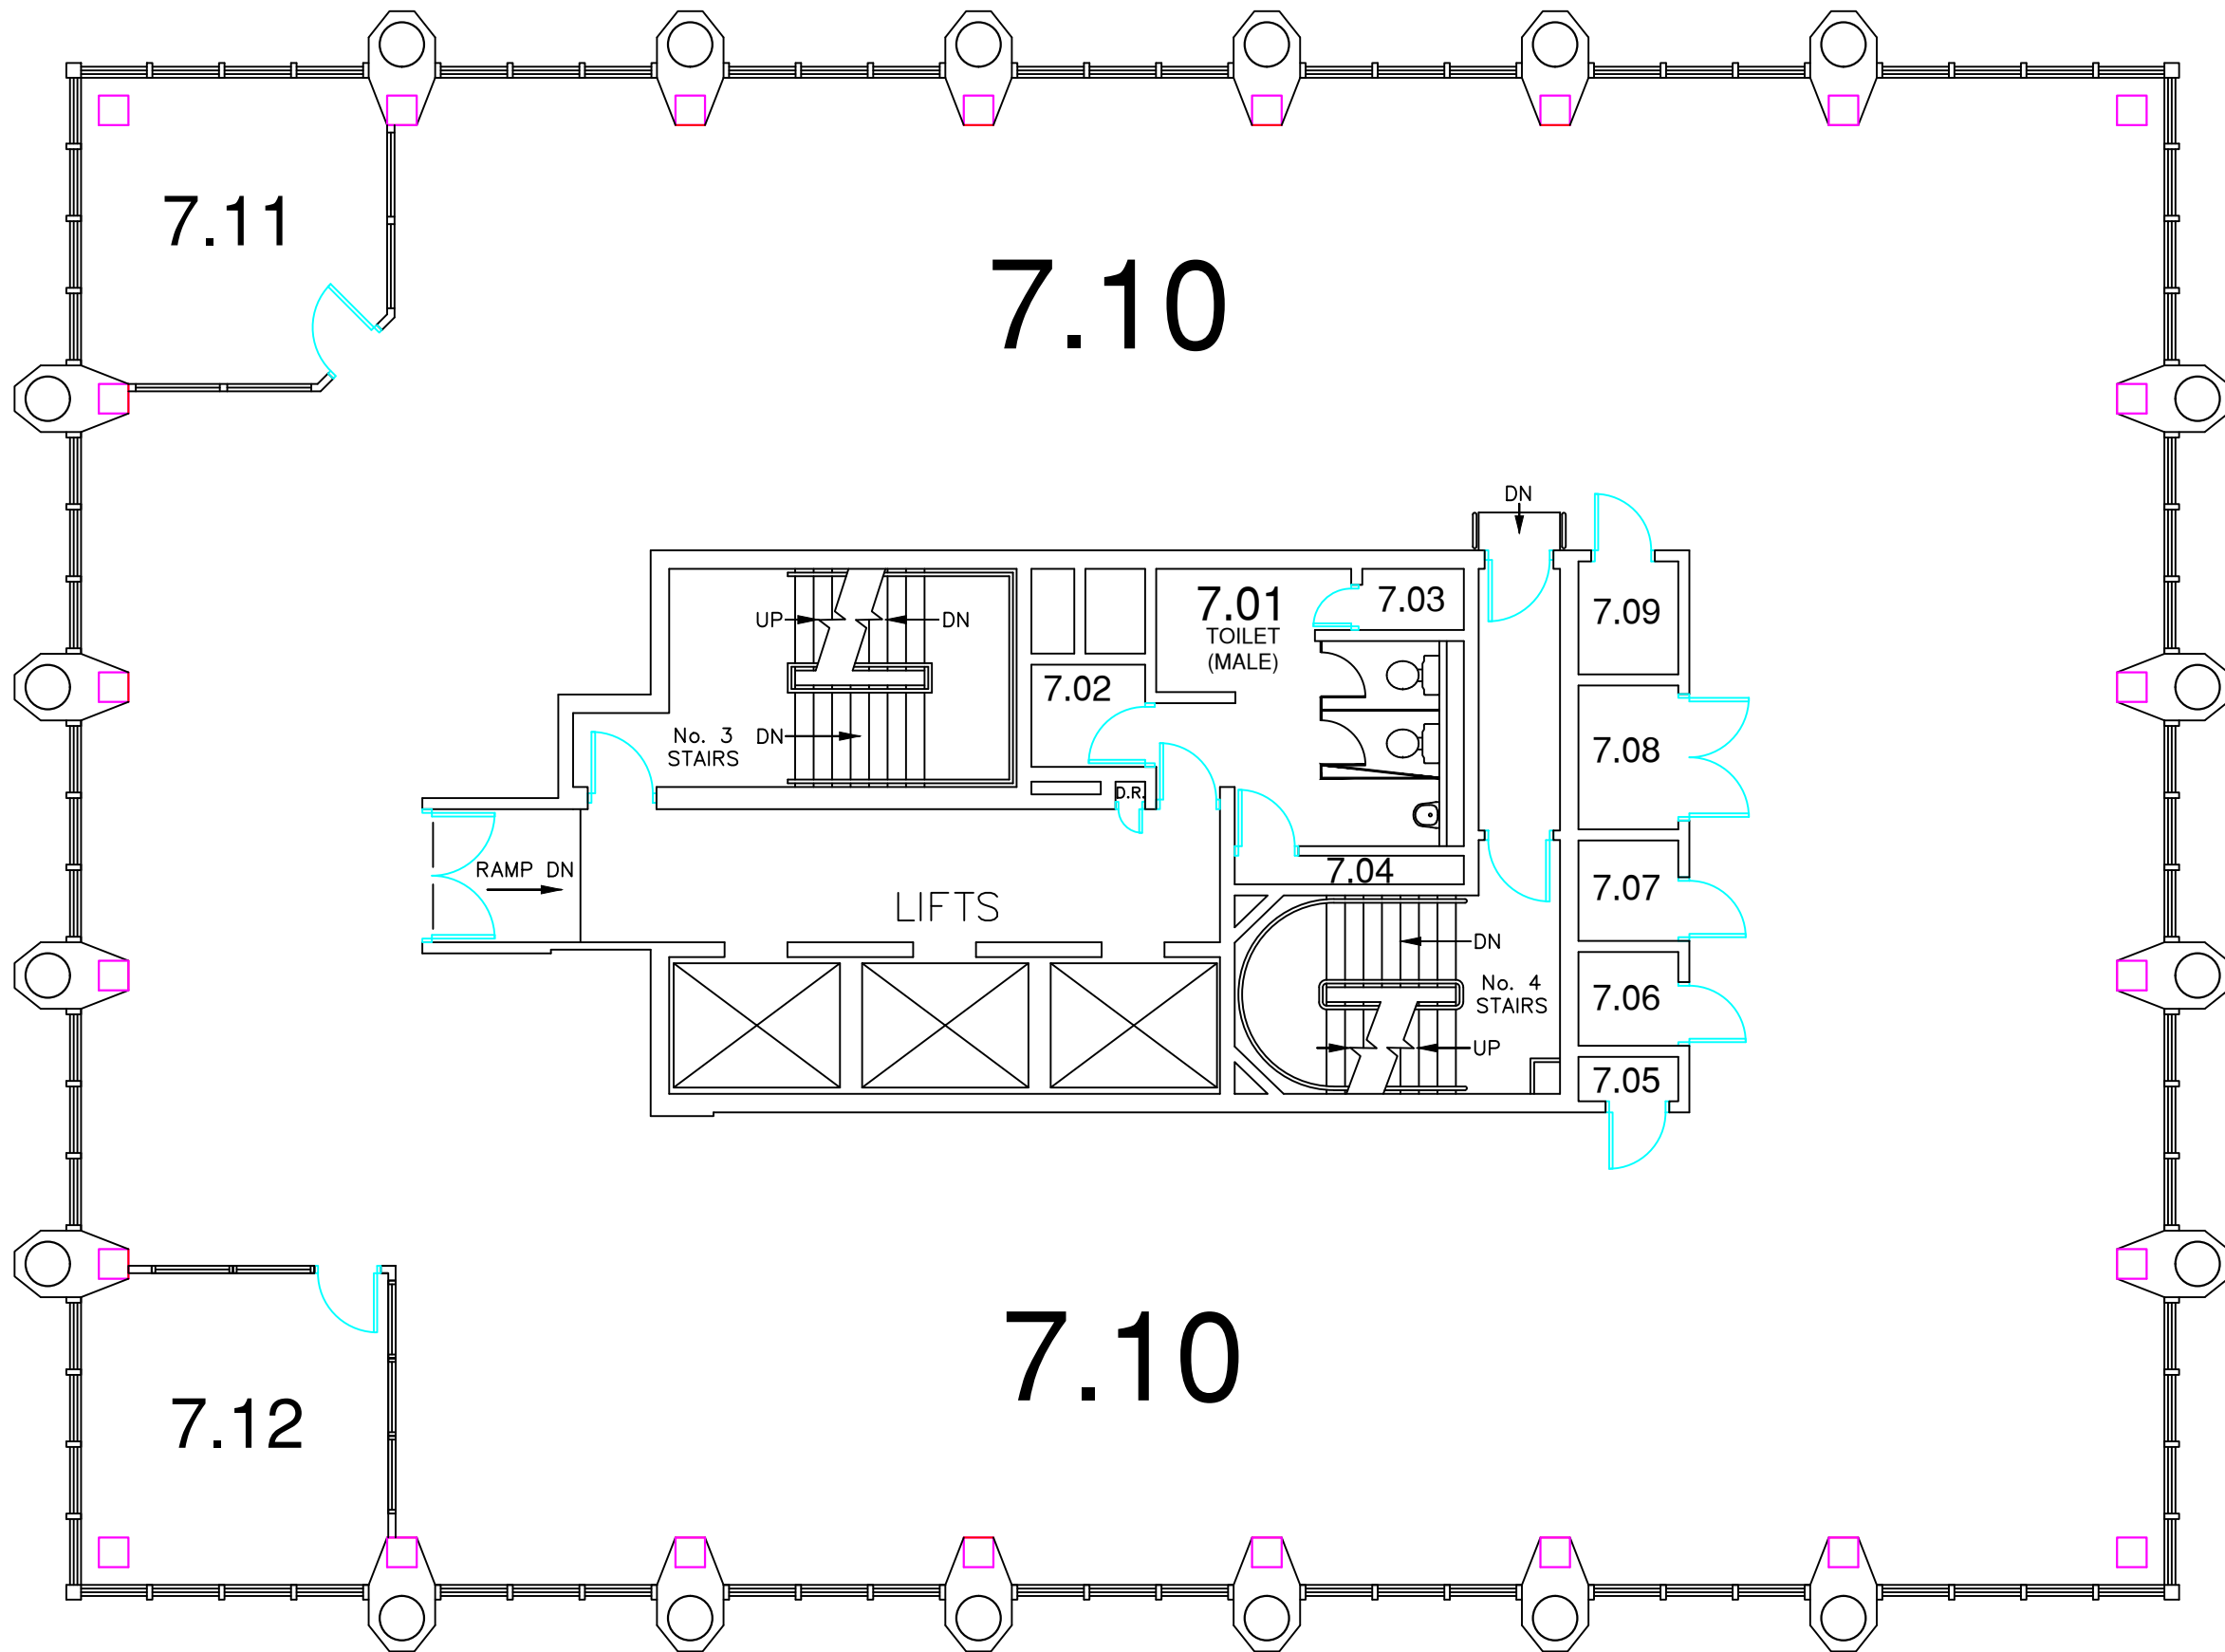


Estates

Title
**McKENZIE HOUSE.
 SEVENTH FLOOR PLAN.**



Scale: 1:100 \A3 SHEET	Original Layout Drawn: GPI
Last Revised Drawn/Date:	RLF - 15/09/2020
Rec. Drg. No.:	AN \AN10 \FP \07

Record Drawing

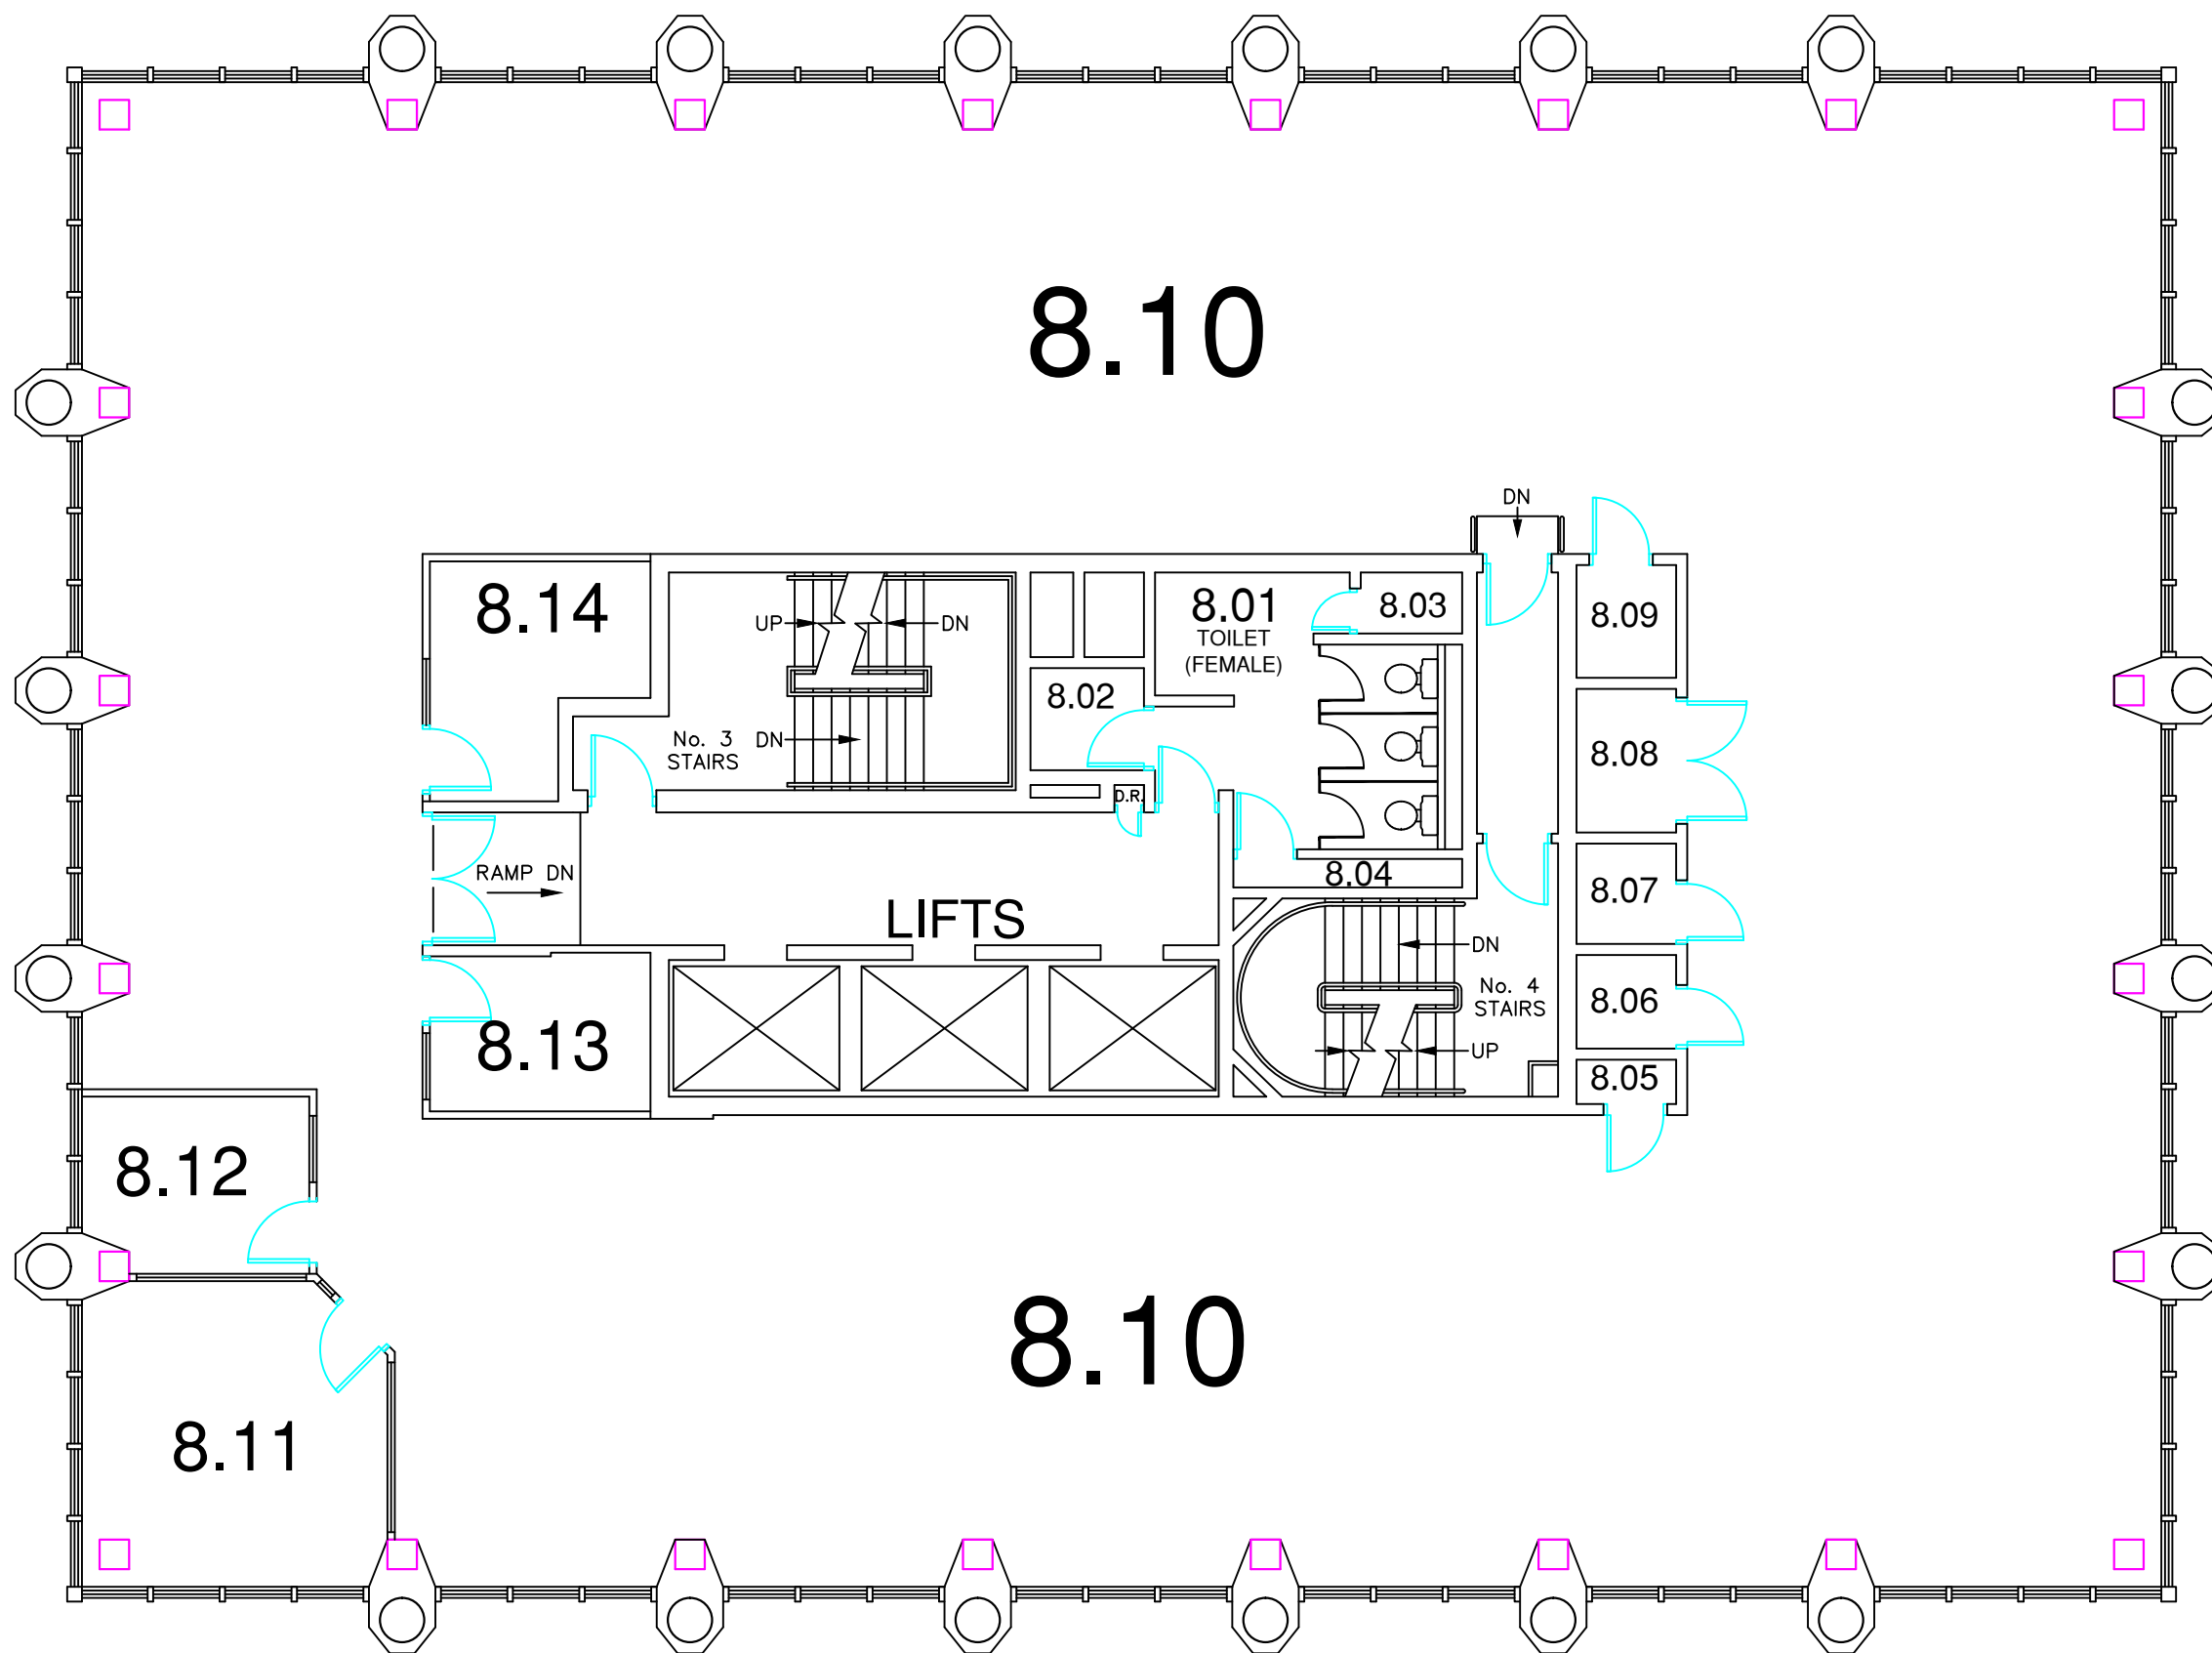


8.10


8.10

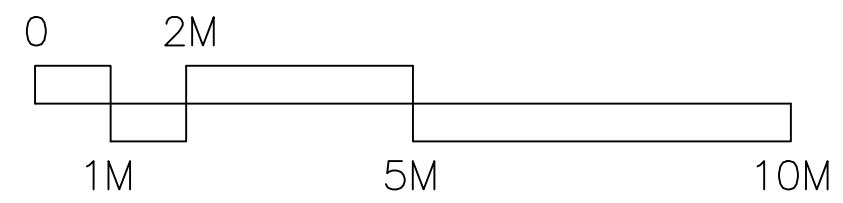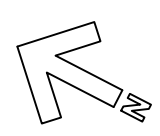

 Estates	
Title McKENZIE HOUSE. EIGHTH FLOOR PLAN.	
Scale: 1:100 \A3 SHEET	Original Layout Drawn: GPI
Last Revised Drawn/Date:	RLF - 15/09/2020
Rec. Drg. No.:	AN\AN10\FP\08
Record Drawing	


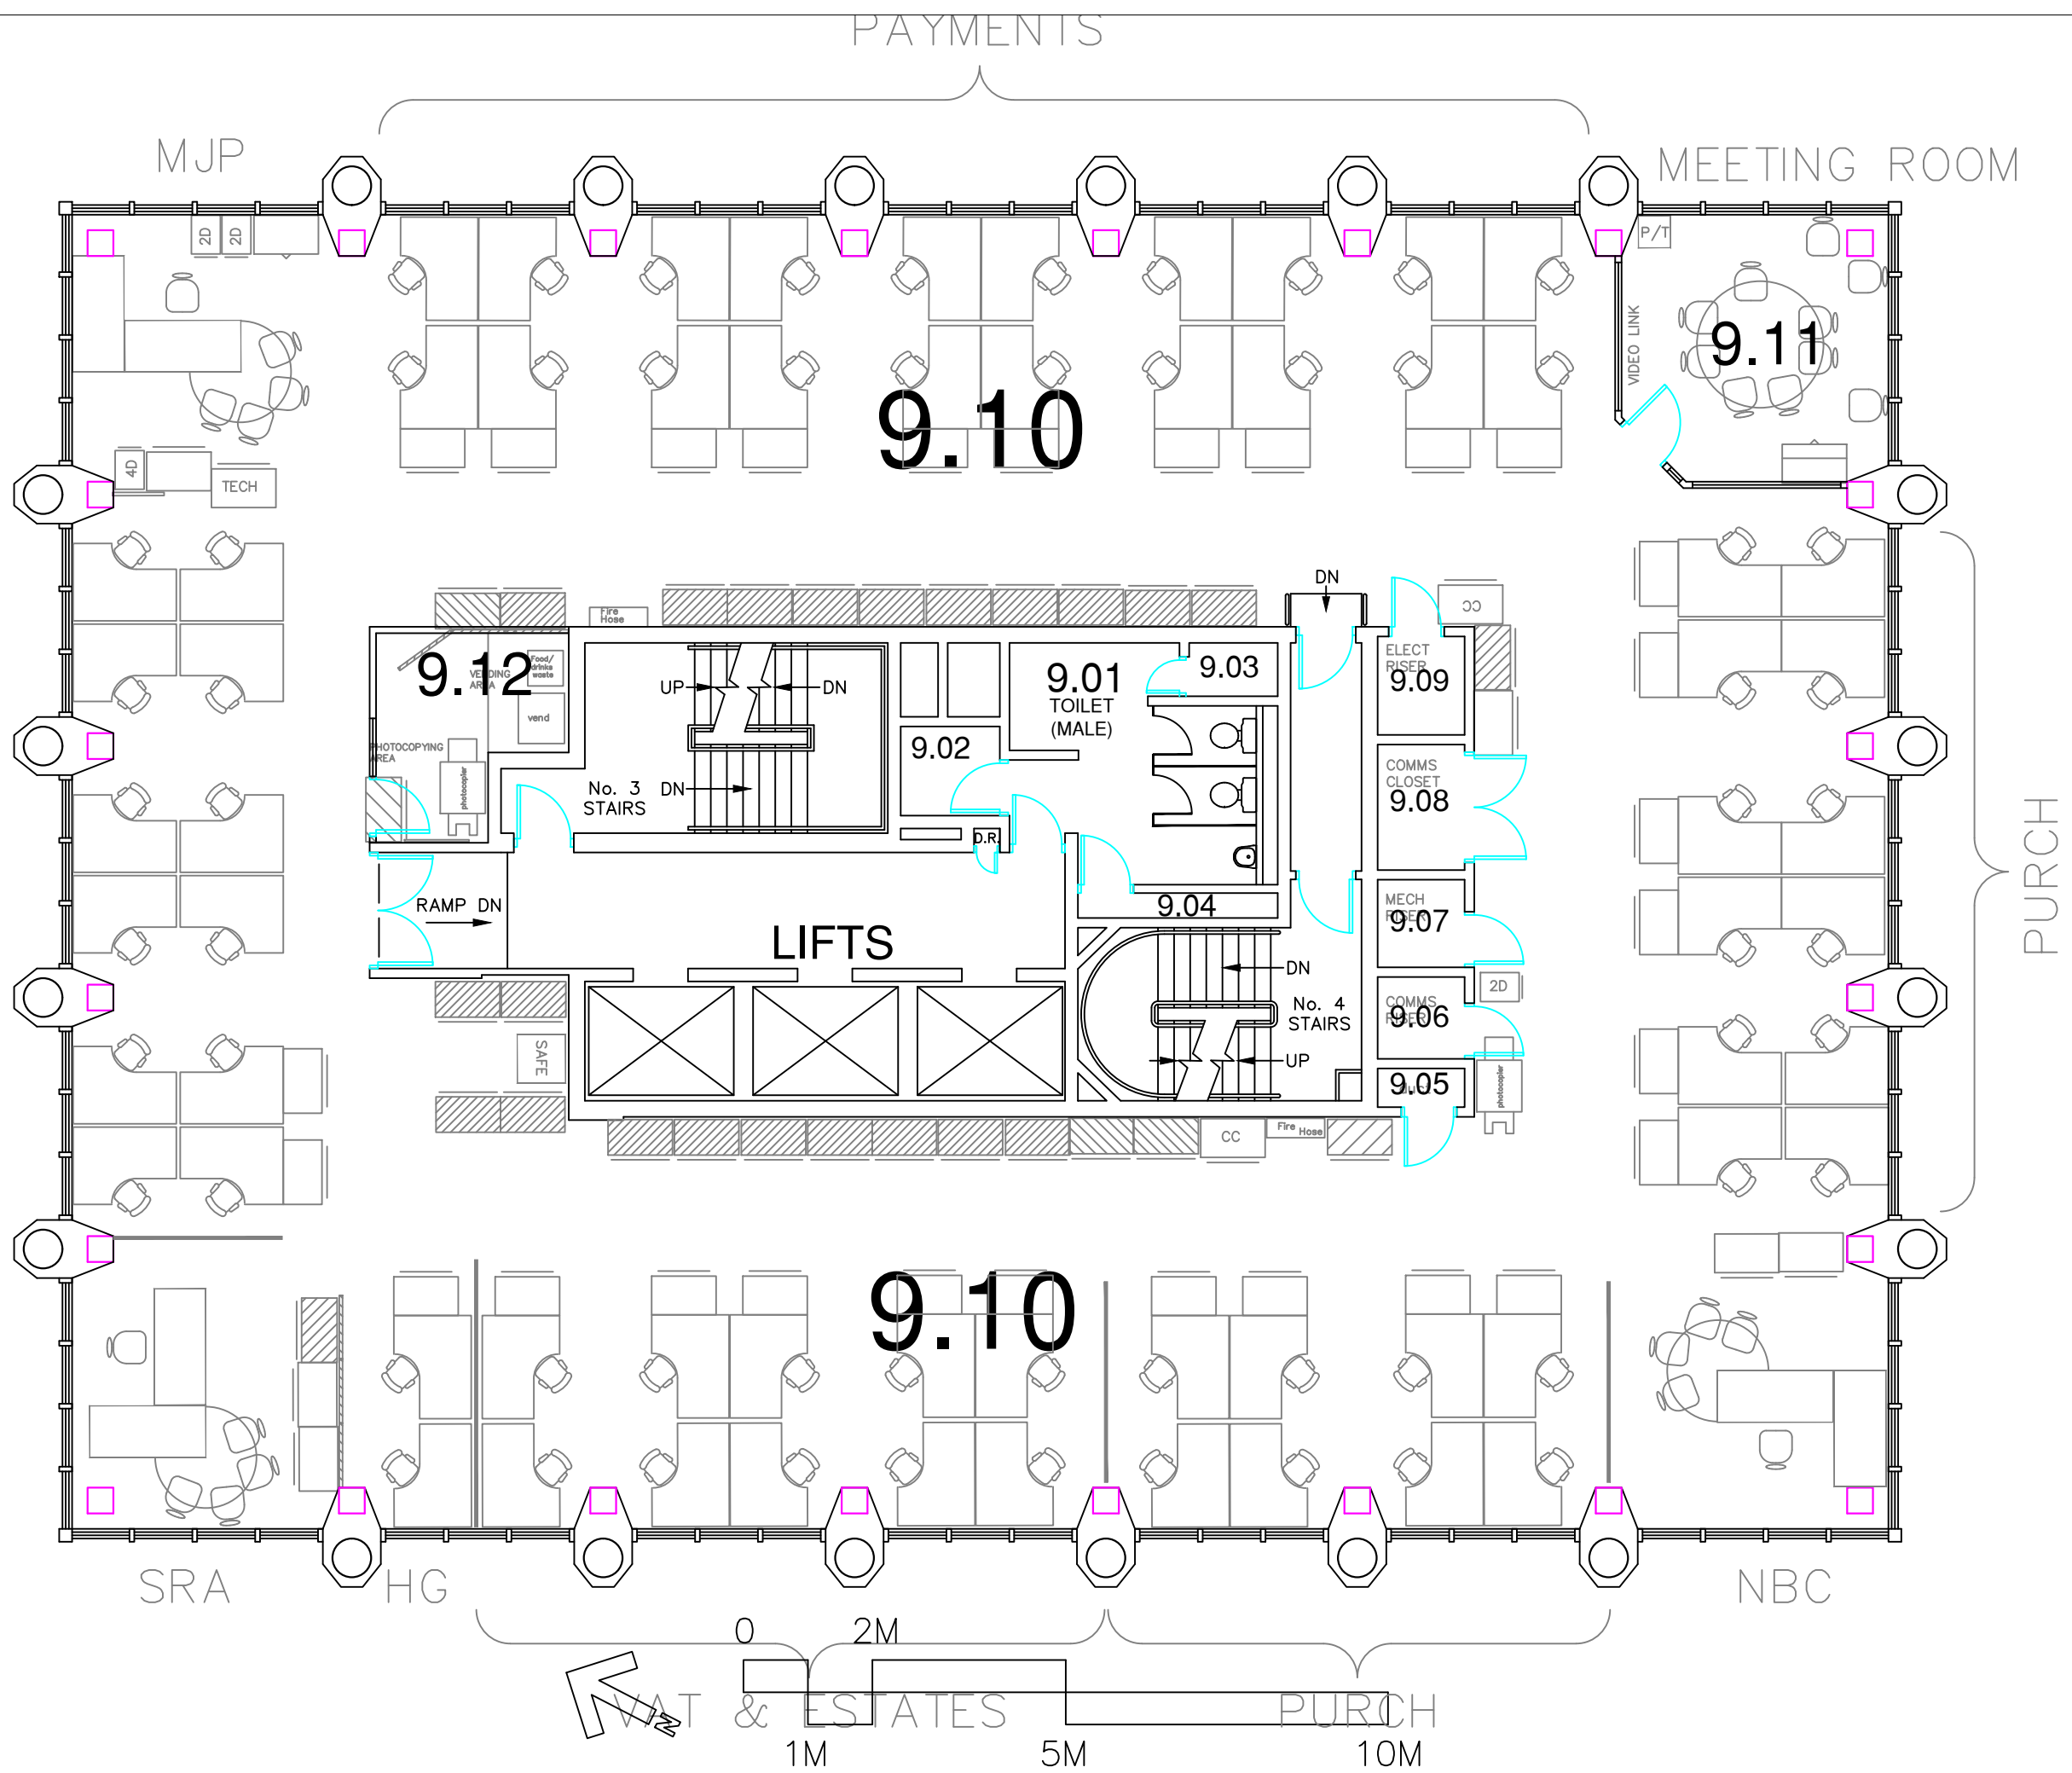



Estates	
Title McKENZIE HOUSE. NINTH FLOOR PLAN.	
Scale: 1:100\A3 SHEET	Original Layout Drawn: GPI
Last Revised Drawn/Date: RLF - 15/09/2020	Rec. Drg. No.: AN\AN10\FP\09
Record Drawing	

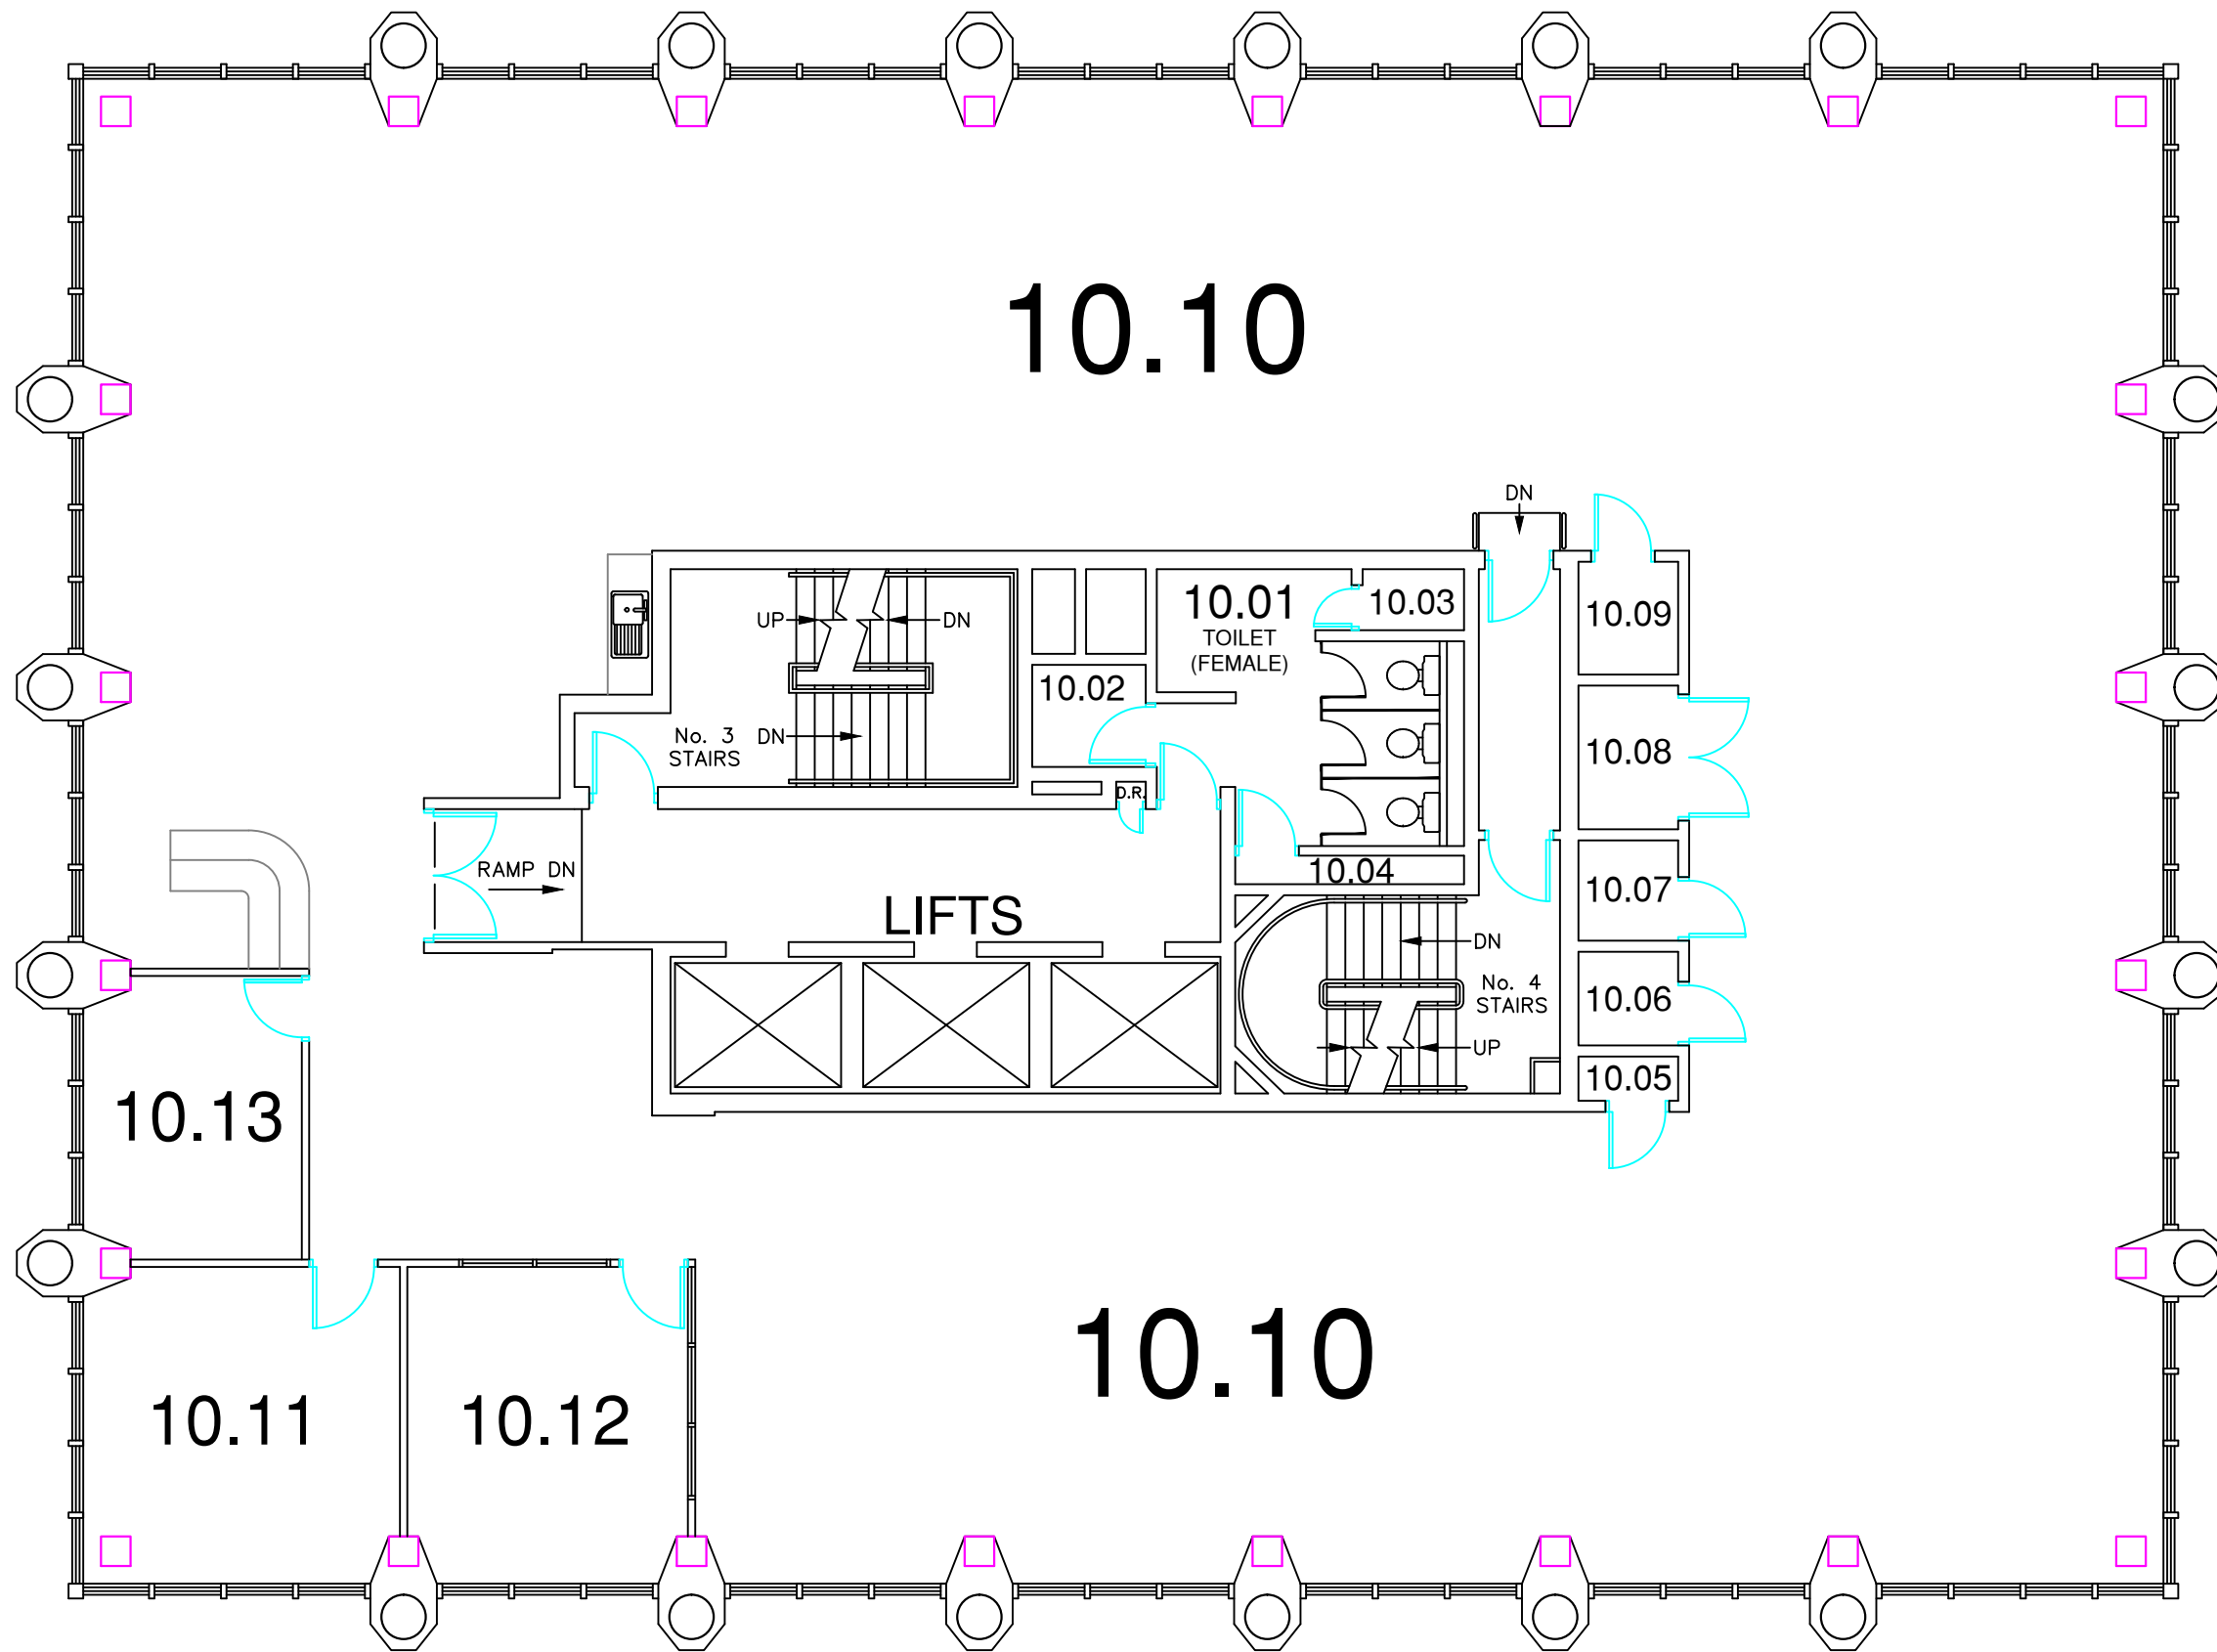


10.10



10.10

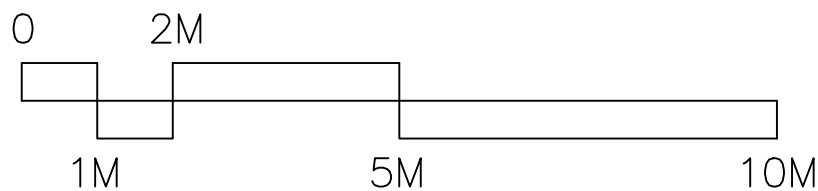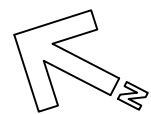


 Estates	
Title McKENZIE HOUSE. TENTH FLOOR PLAN.	
Scale: 1:100 \A3 SHEET	Original Layout Drawn: GPI
Last Revised Drawn/Date: RLF - 15/09/2020	
Rec. Drg. No.: AN\AN10\FP\10	
Record Drawing	

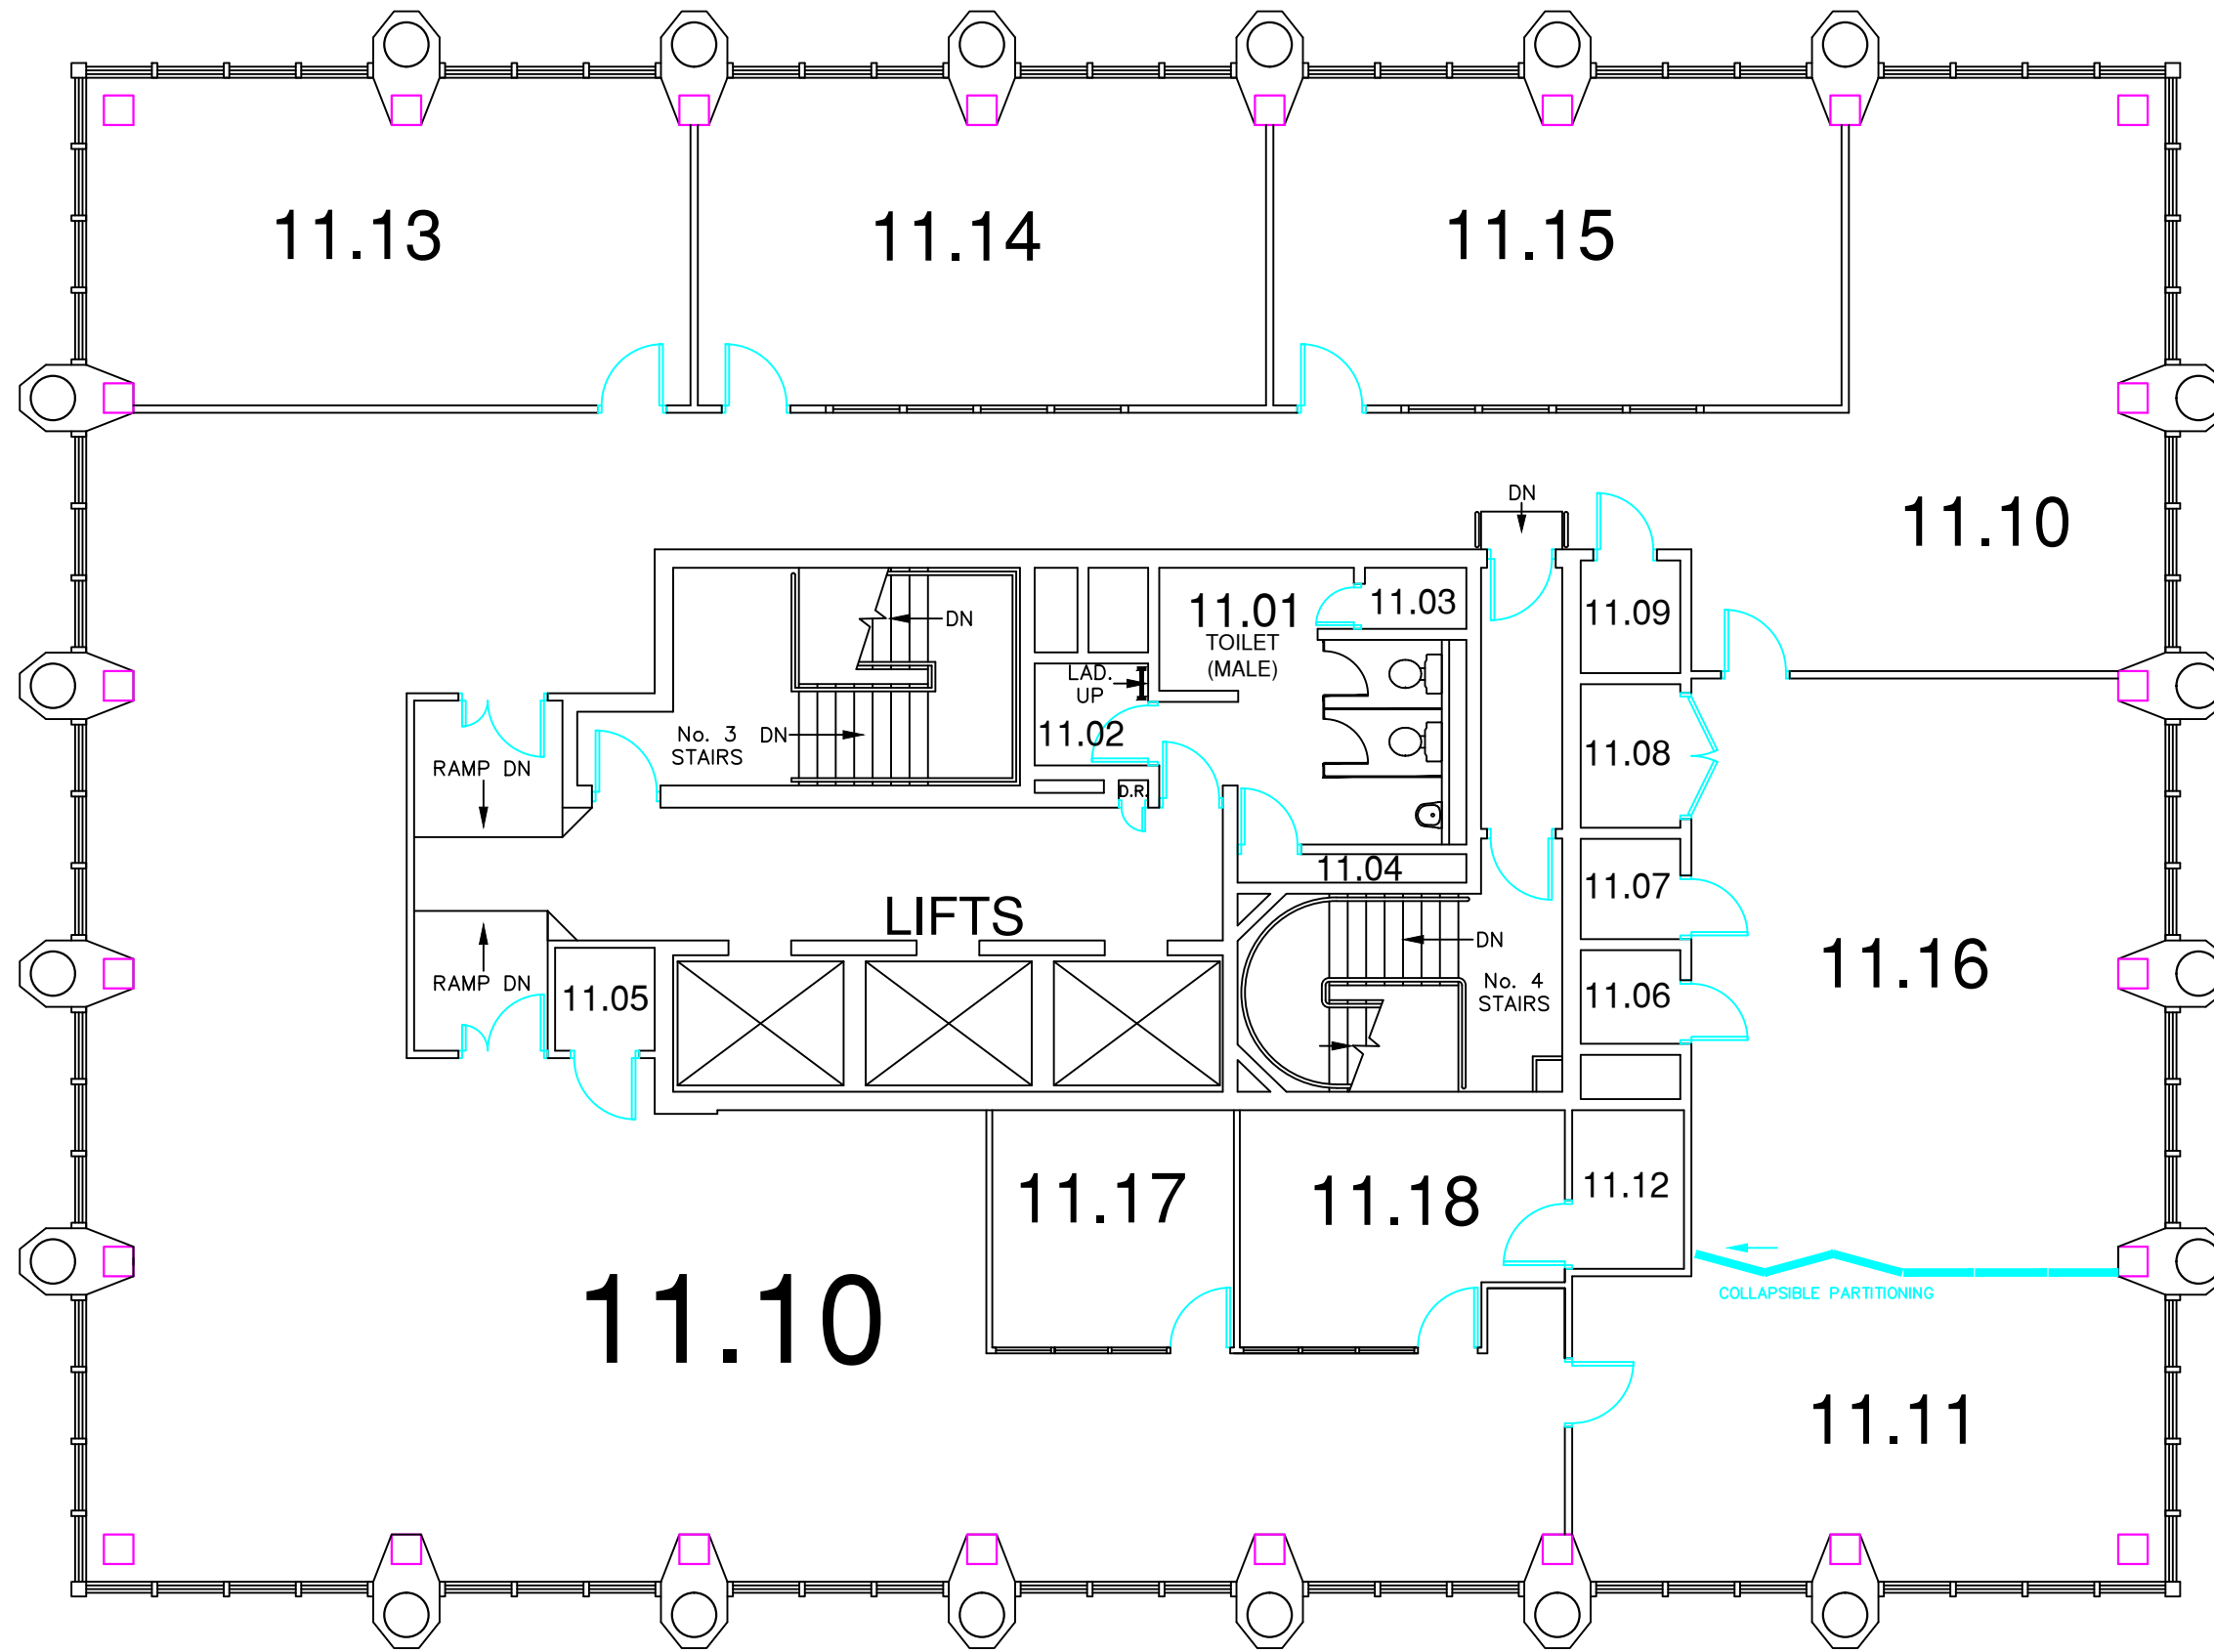

11.10

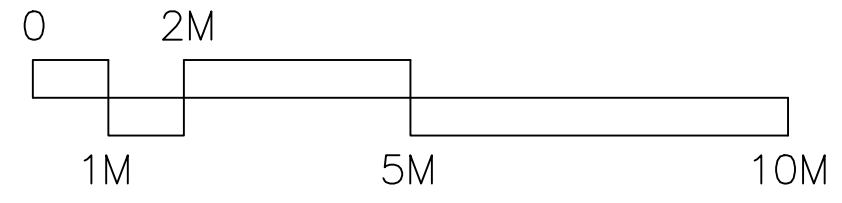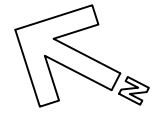

 Estates	
Title McKENZIE HOUSE. ELEVENTH FLOOR PLAN.	
Scale: 1:100 \A3 SHEET	Original Layout Drawn: GPI
Last Revised Drawn/Date: RLF - 15/09/2020	Rec. Drg. No.: AN\AN10\FP\11
Record Drawing	