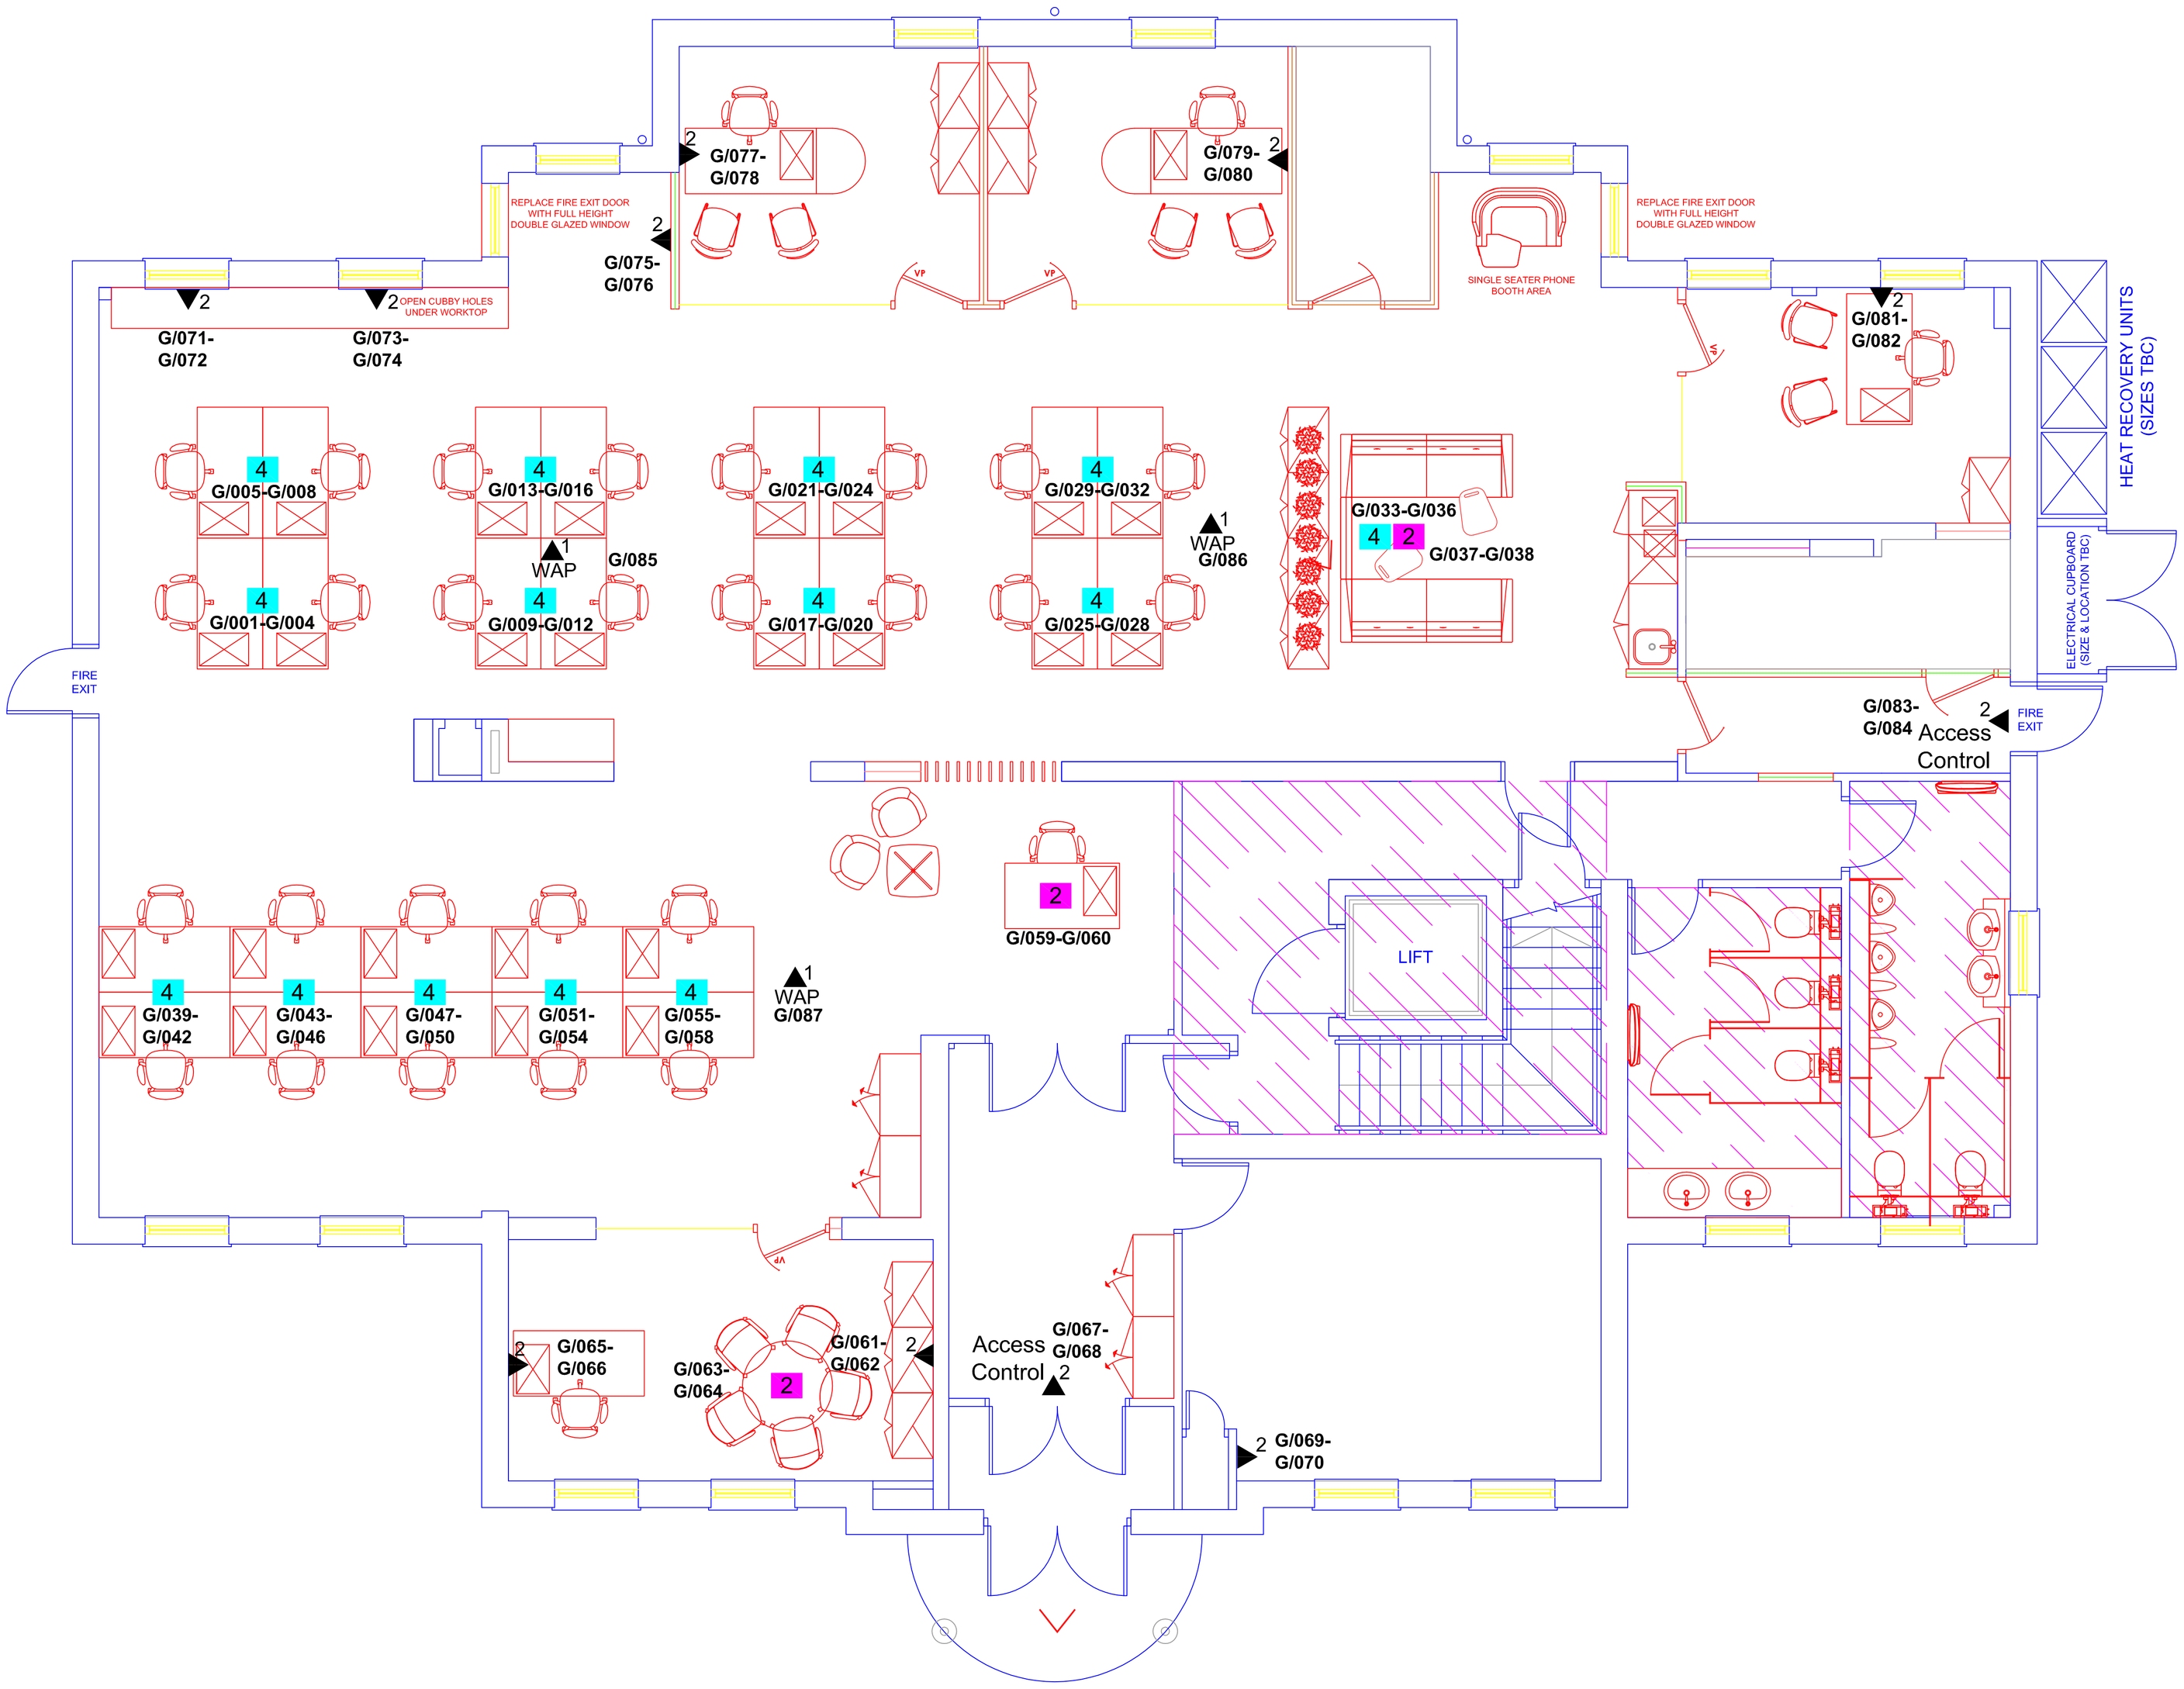

"Our aim is to provide a fast, accurate and competitive quotation, followed by a hassle free, professional installation carried out by qualified experienced engineers"

REFERENCE DRAWING TRACKER

Trade/Description	Drawing No.	Rev	Date Rec'd

Rev	Description	Chk'd	Date

Project Title:
Sailors' Society
74 St Anne's Road
Southampton

Drawing Title:
Ground Floor
DNS Layout

Drawing Status:
As Installed

Scale: NTS
Date: 11/11/15
Drawn By: AF
Checked By: -
Approved By: -

progressive

Unit 3, Colne Way Court
Colne Way
Watford
WD24 7NE

Drawing Number: Q7231-G-DNS
Revision: 0