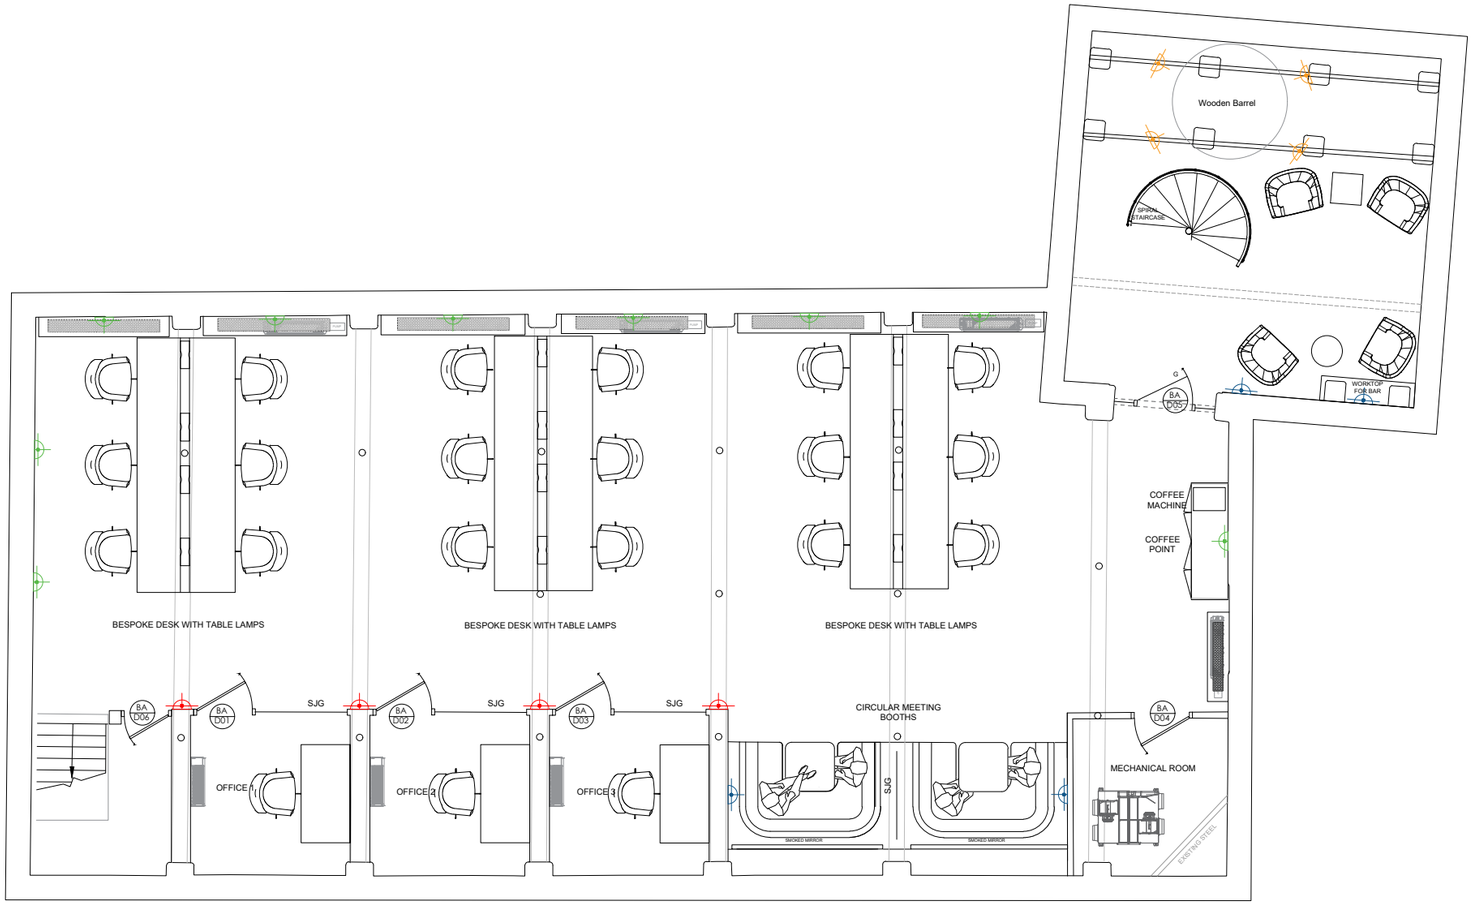

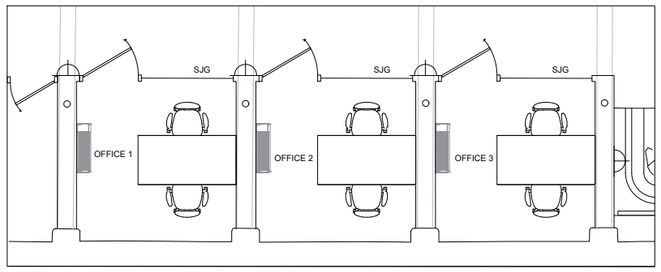

ALTERNATIVE OFFICE LAYOUT

No part of this drawing can be copied without the written consent of Space & Solutions Ltd

No part of this drawing should be scaled. For dimensions and information relating to this drawing contact Space & Solutions Ltd. All contractors must visit site and be responsible for taking and checking dimesions

INFORMATION:

- Drawing Subject to Full Site Survey
- Building Parameter Provided to Space & Solutions Ltd
- Check Survey Undertaken Only

RECORD DRAWING

Space London
21 Ironmonger Lane
London // EC2V 8EY
T // +44 (0)20 3740 1080

Space South
9 Queensway // New Milton
Hampshire // BH25 5NN
T // +44 (0)1425 629 639

hello@spaceandsolutions.com
spaceandsolutions.com

REV	DATE	REVISION INFO	DRAWN
--	--	--	--
--	--	--	--
SPACE

Approved: Date:

Drawing Title:
GENERAL ARRANGEMENT - BASEMENT

Client:
LIAM DOE

Project:
THE OLD BOND STORE
BACK OF THE WALLS
SOUTHAMPTON
SO14 3BH

Scale:	Date:	Drawn By:	Checked By:
1:50 @ A1	29/10/19	LW	JH

Drawing Number

Project & Dwg No:	Level:	Type:	Rev:
18080	BASE	GA	RD

Status

☐ Information ☐ Tender ☐ Construction ☐ Record