THE INFORMATION CONTAINED HEREIN IS CLASSIFIED "CONFIDENTIAL" AND IS THE SOLE PROPERTY OF MAPELEY LIMITED AND WE USE THERE OF AND OR REPRODUCTION THERE OF IS STRICTLY PROHIBITED WITHOUT THE WRITTEN CONSENT OF MAPELEY LIMITED.

It is the responsibility of Contractors and/or Clients to check measurements displayed on the drawings. Mapeley accepts no responsibility for errors brought about by incorrect measurements.

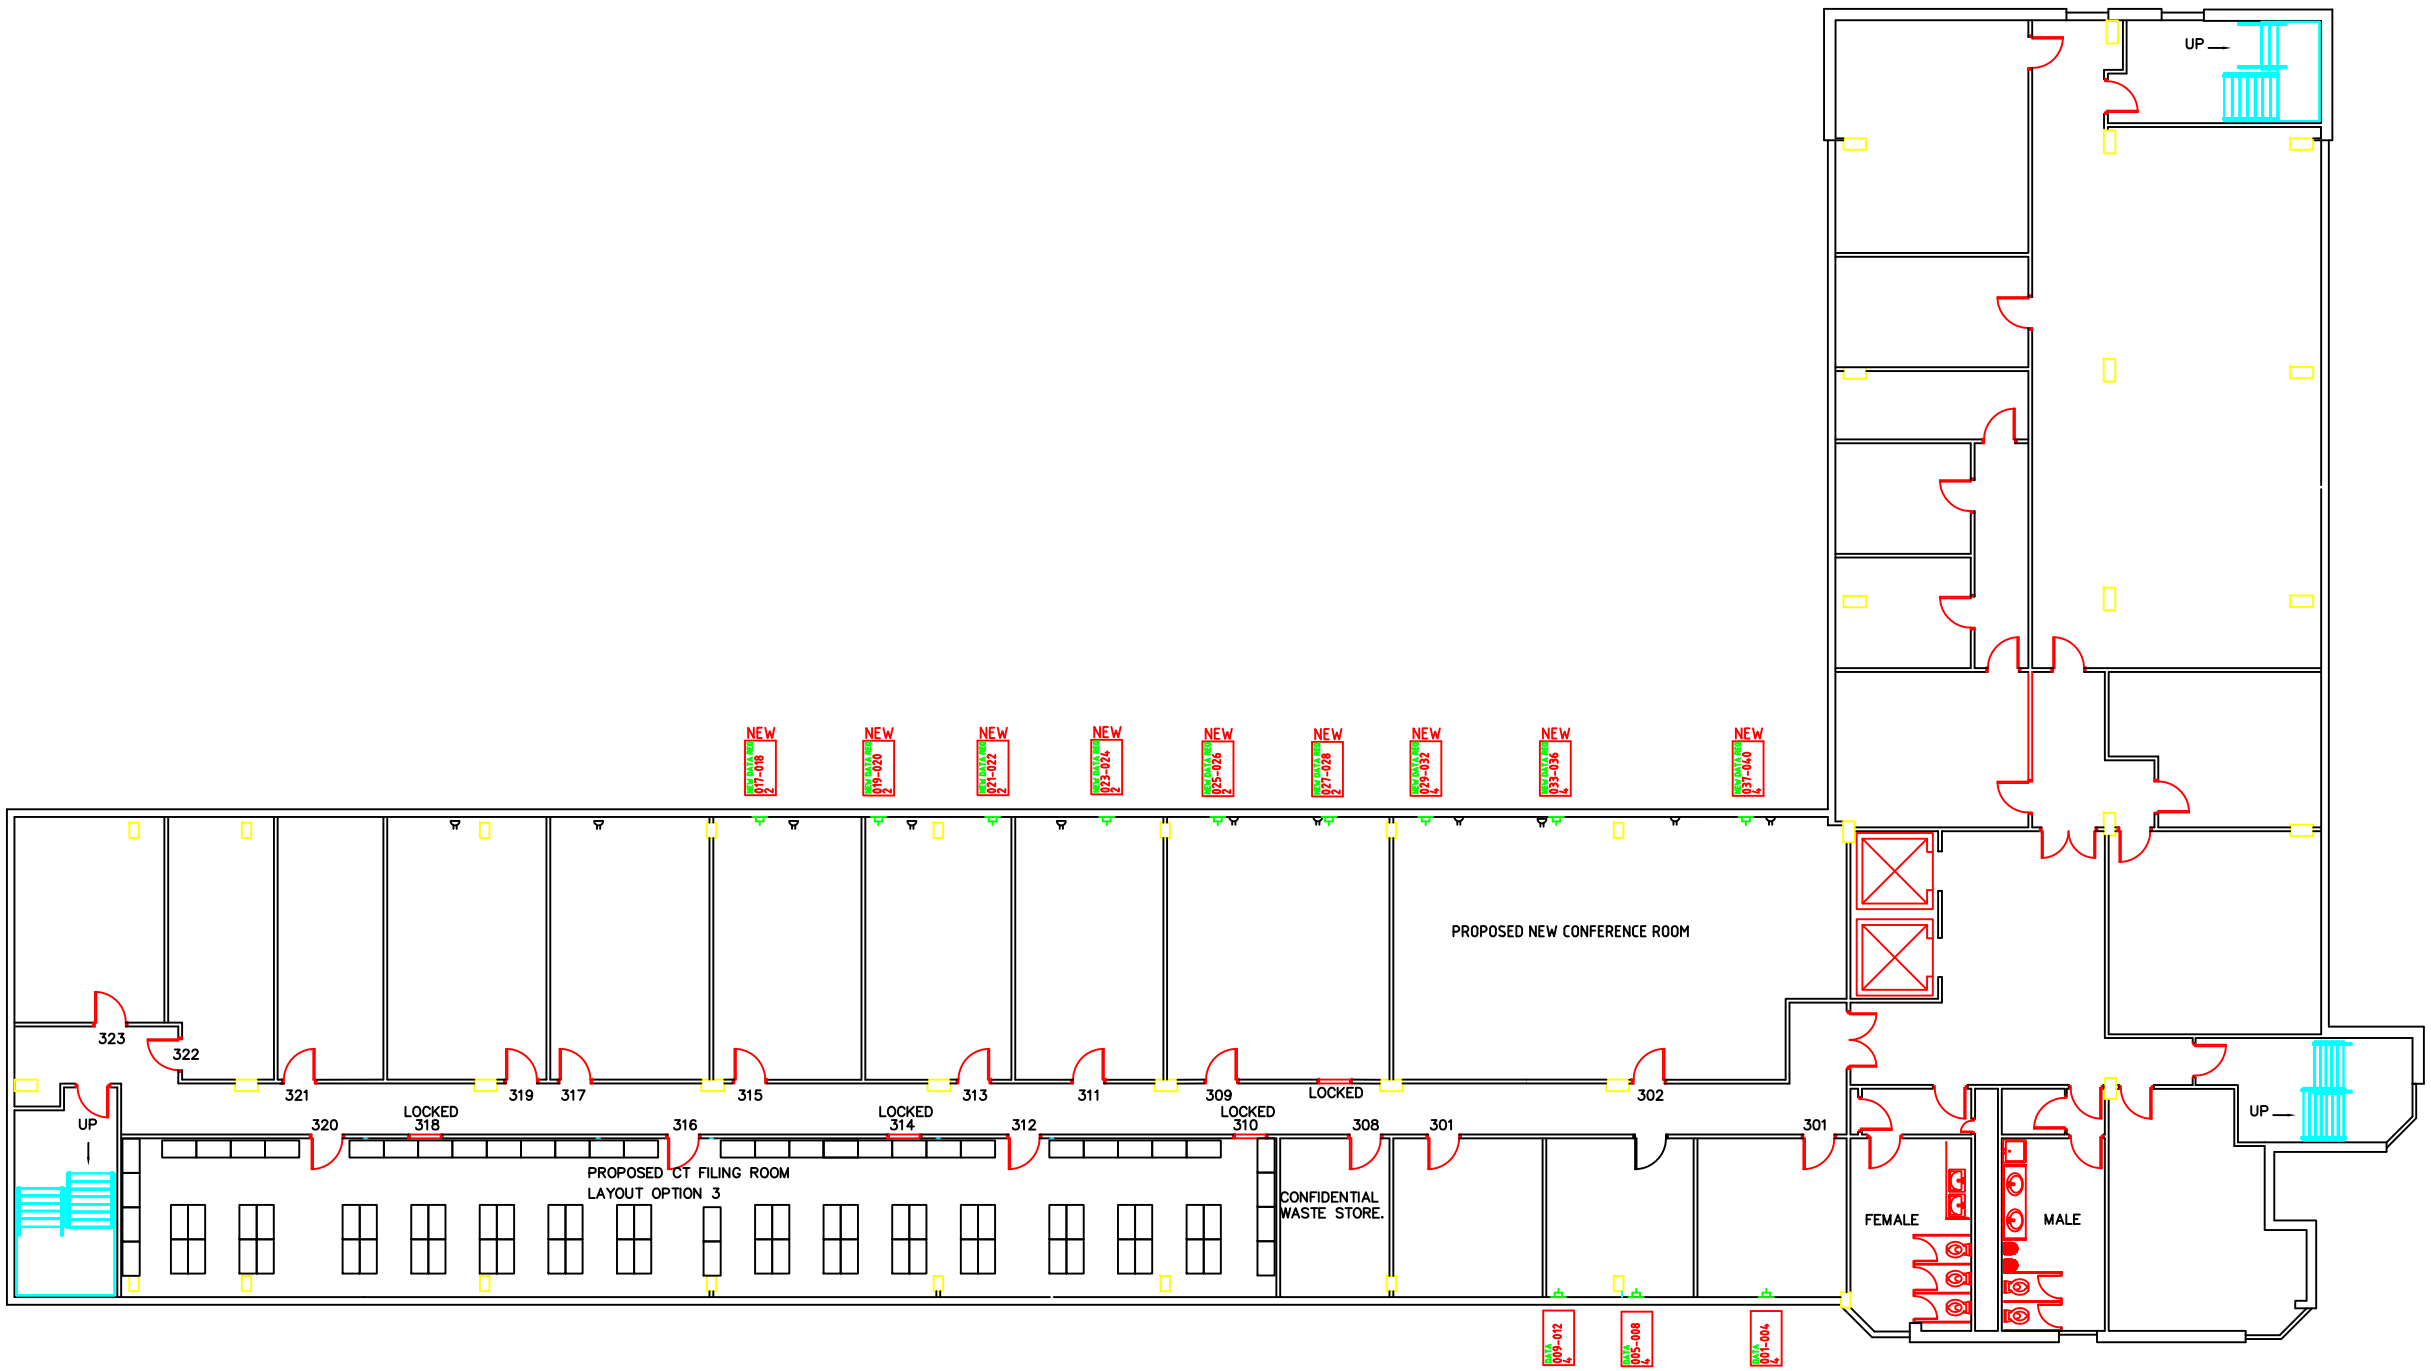

AS BUILT - THIRD FLOOR

SCALE 1:100

Rev.	Date / Description	Initial	Sign

- Preliminary Information
- Approval Comments
- Contract
- As Built
- Construction
- Building Control

Client Approval

Depts. Rep. Name: . . . . . .

signed : . . . . . date : . . . . . .

Mapeley Limited
33rd/34th Floor
Euston Tower
286 Euston Road
London, England. NW1 3AS
Tel: 0845 113 3222
Fax: 0207 788 1701

In Partnership With

INTERSERVE PROJECT SERVICES LIMITED
Design Services
INTERSERVE
255 GEORGE ROAD,
ERDINGTON,
BIRMINGHAM,
B23 7RD.

Building Name
TY NANT

Facility Address
180 HIGH STREET
SWANSEA
SA1 5AP

Project Description
WEST WALES AREA MANAGEMENT SCHEME

Drawing Title
AS BUILT
THIRD FLOOR

CWO / DFCE REF.	ECMU
242129	CARDIFF

Checked	For Interserve Project Services	
Drawn	Date	Scale
M.CORBETT	17.02.04	1:100 @A1
STEPS Code	Drawing No	
	3038/0022/A1/12	